


# DRAWING TO ACCOMPANY REPORT

#50985

Situated in the State of Ohio, County of Lorain, City of Avon Lake, known as being a part of Original Avon Township Section No. 18

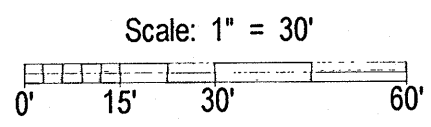


prepared by:

**ZWICK ASSOCIATES, Inc.**

Engineers - Surveyors - Planners

8750 Stearns Road, Olmsted Township, Ohio 44138  
Tel: 440 - 235 - 2729 fax: 440 - 235 - 0604

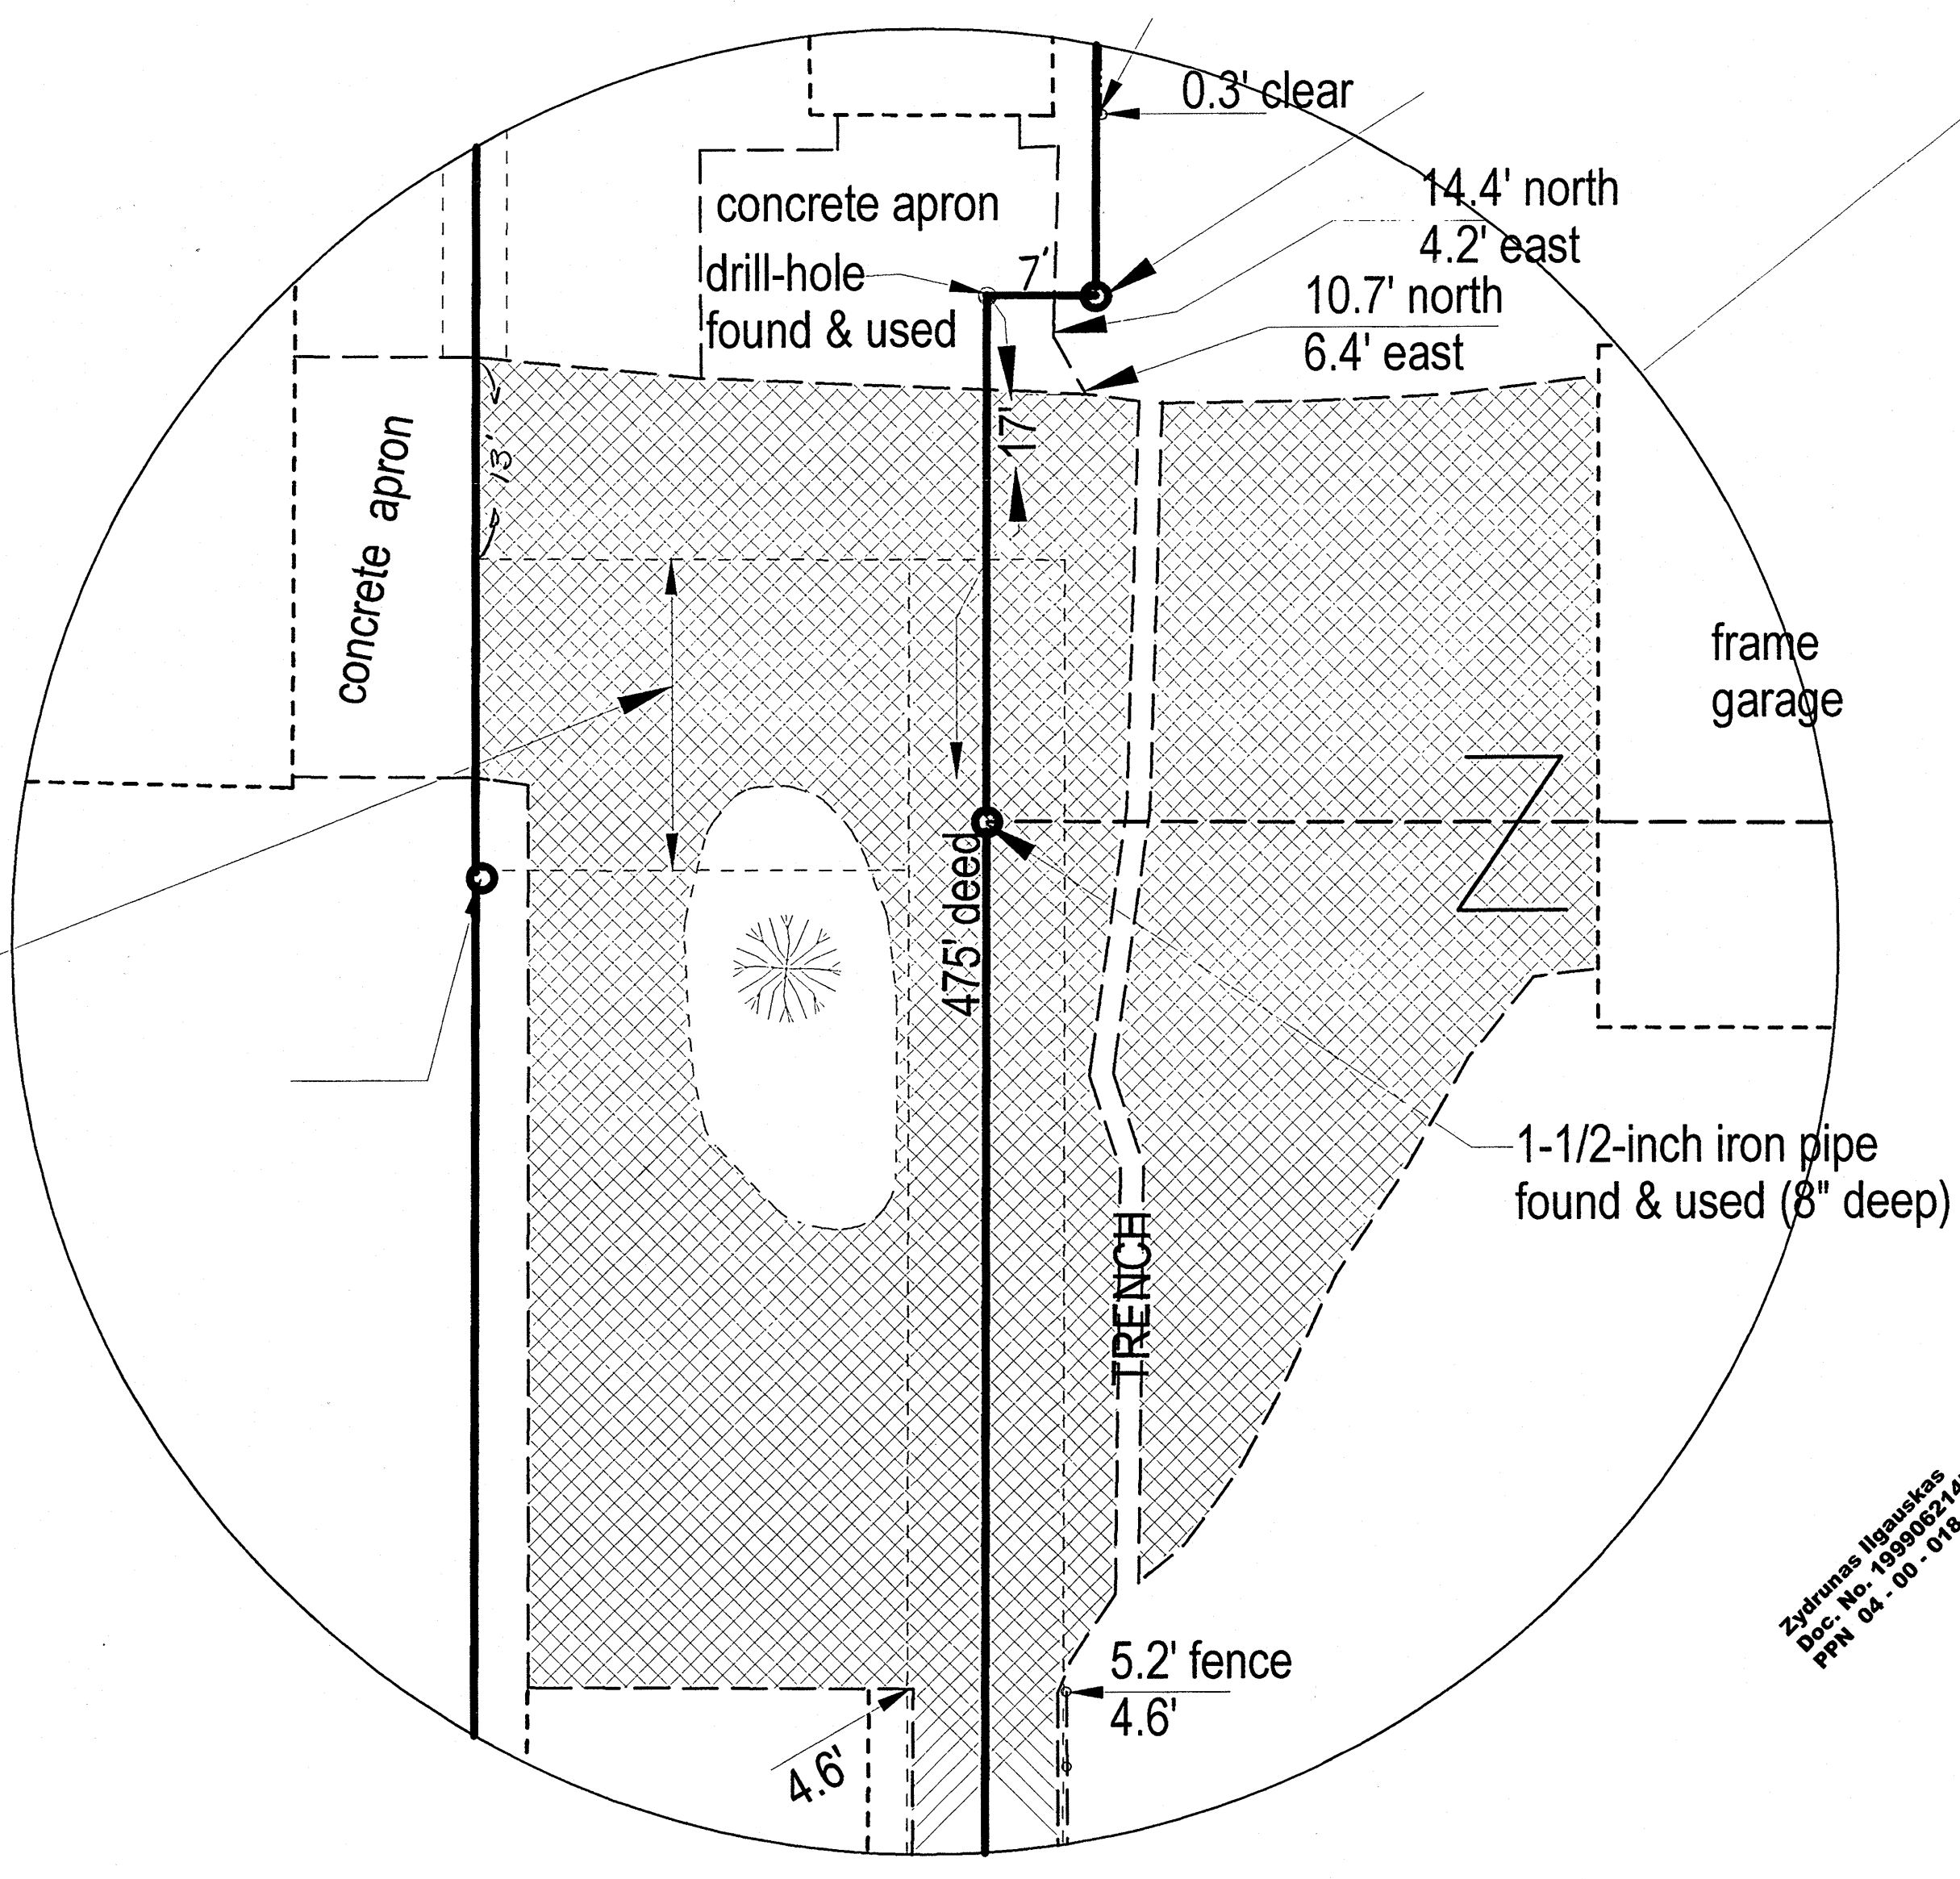

DETAIL Scale: 1" = 10'


Robert W. & Gaylene Mackenzie  
Doc. No. 1989524103  
PPN 04-00-016-130-017

Cly B. & M. M. Therp  
Doc. No. 1989524116  
PPN 04-00-016-130-022

