



PLAT OF SURVEY made for DONNA & JOHN CASSETTA

SUBLOT No. 9 OF R. HARDY'S ALTERATION AND ADDITION TO THE PLAT OF BINGHAMPTON, CAMDEN TOWNSHIP, LORAIN COUNTY, OHIO, AS SHOWN BY THE PLAT RECORDED IN VOLUME 3, PAGE 12 OF PLATS --- NOW IN THE VILLAGE OF KIPTON, LORAIN COUNTY, OHIO

ZWICK ASSOCIATES, INC.
 ENGINEERS - SURVEYORS - PLANNERS
 8750 STEARNS ROAD, OLMSTED TOWNSHIP, OHIO 44138
 Email: ZWICK@eng.ohiocoxmail.com Tel: (440) 235-2729

Peter D. Zwick

ZWICK ASSOCIATES, INC.
 PETER D. ZWICK, P.S No. 7429
 May 11, 2012
 #50990

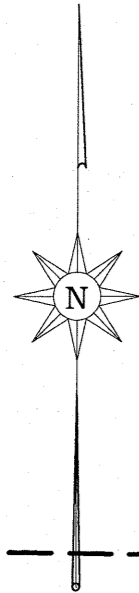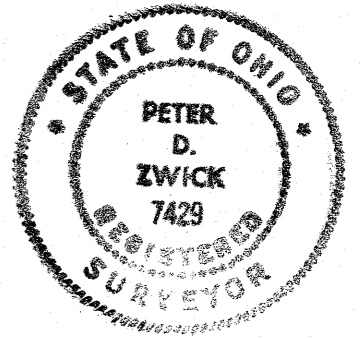

HAWKINS
 STREET 45'

SCALE: 1" = 40'

CHURCH STREET 50'

