
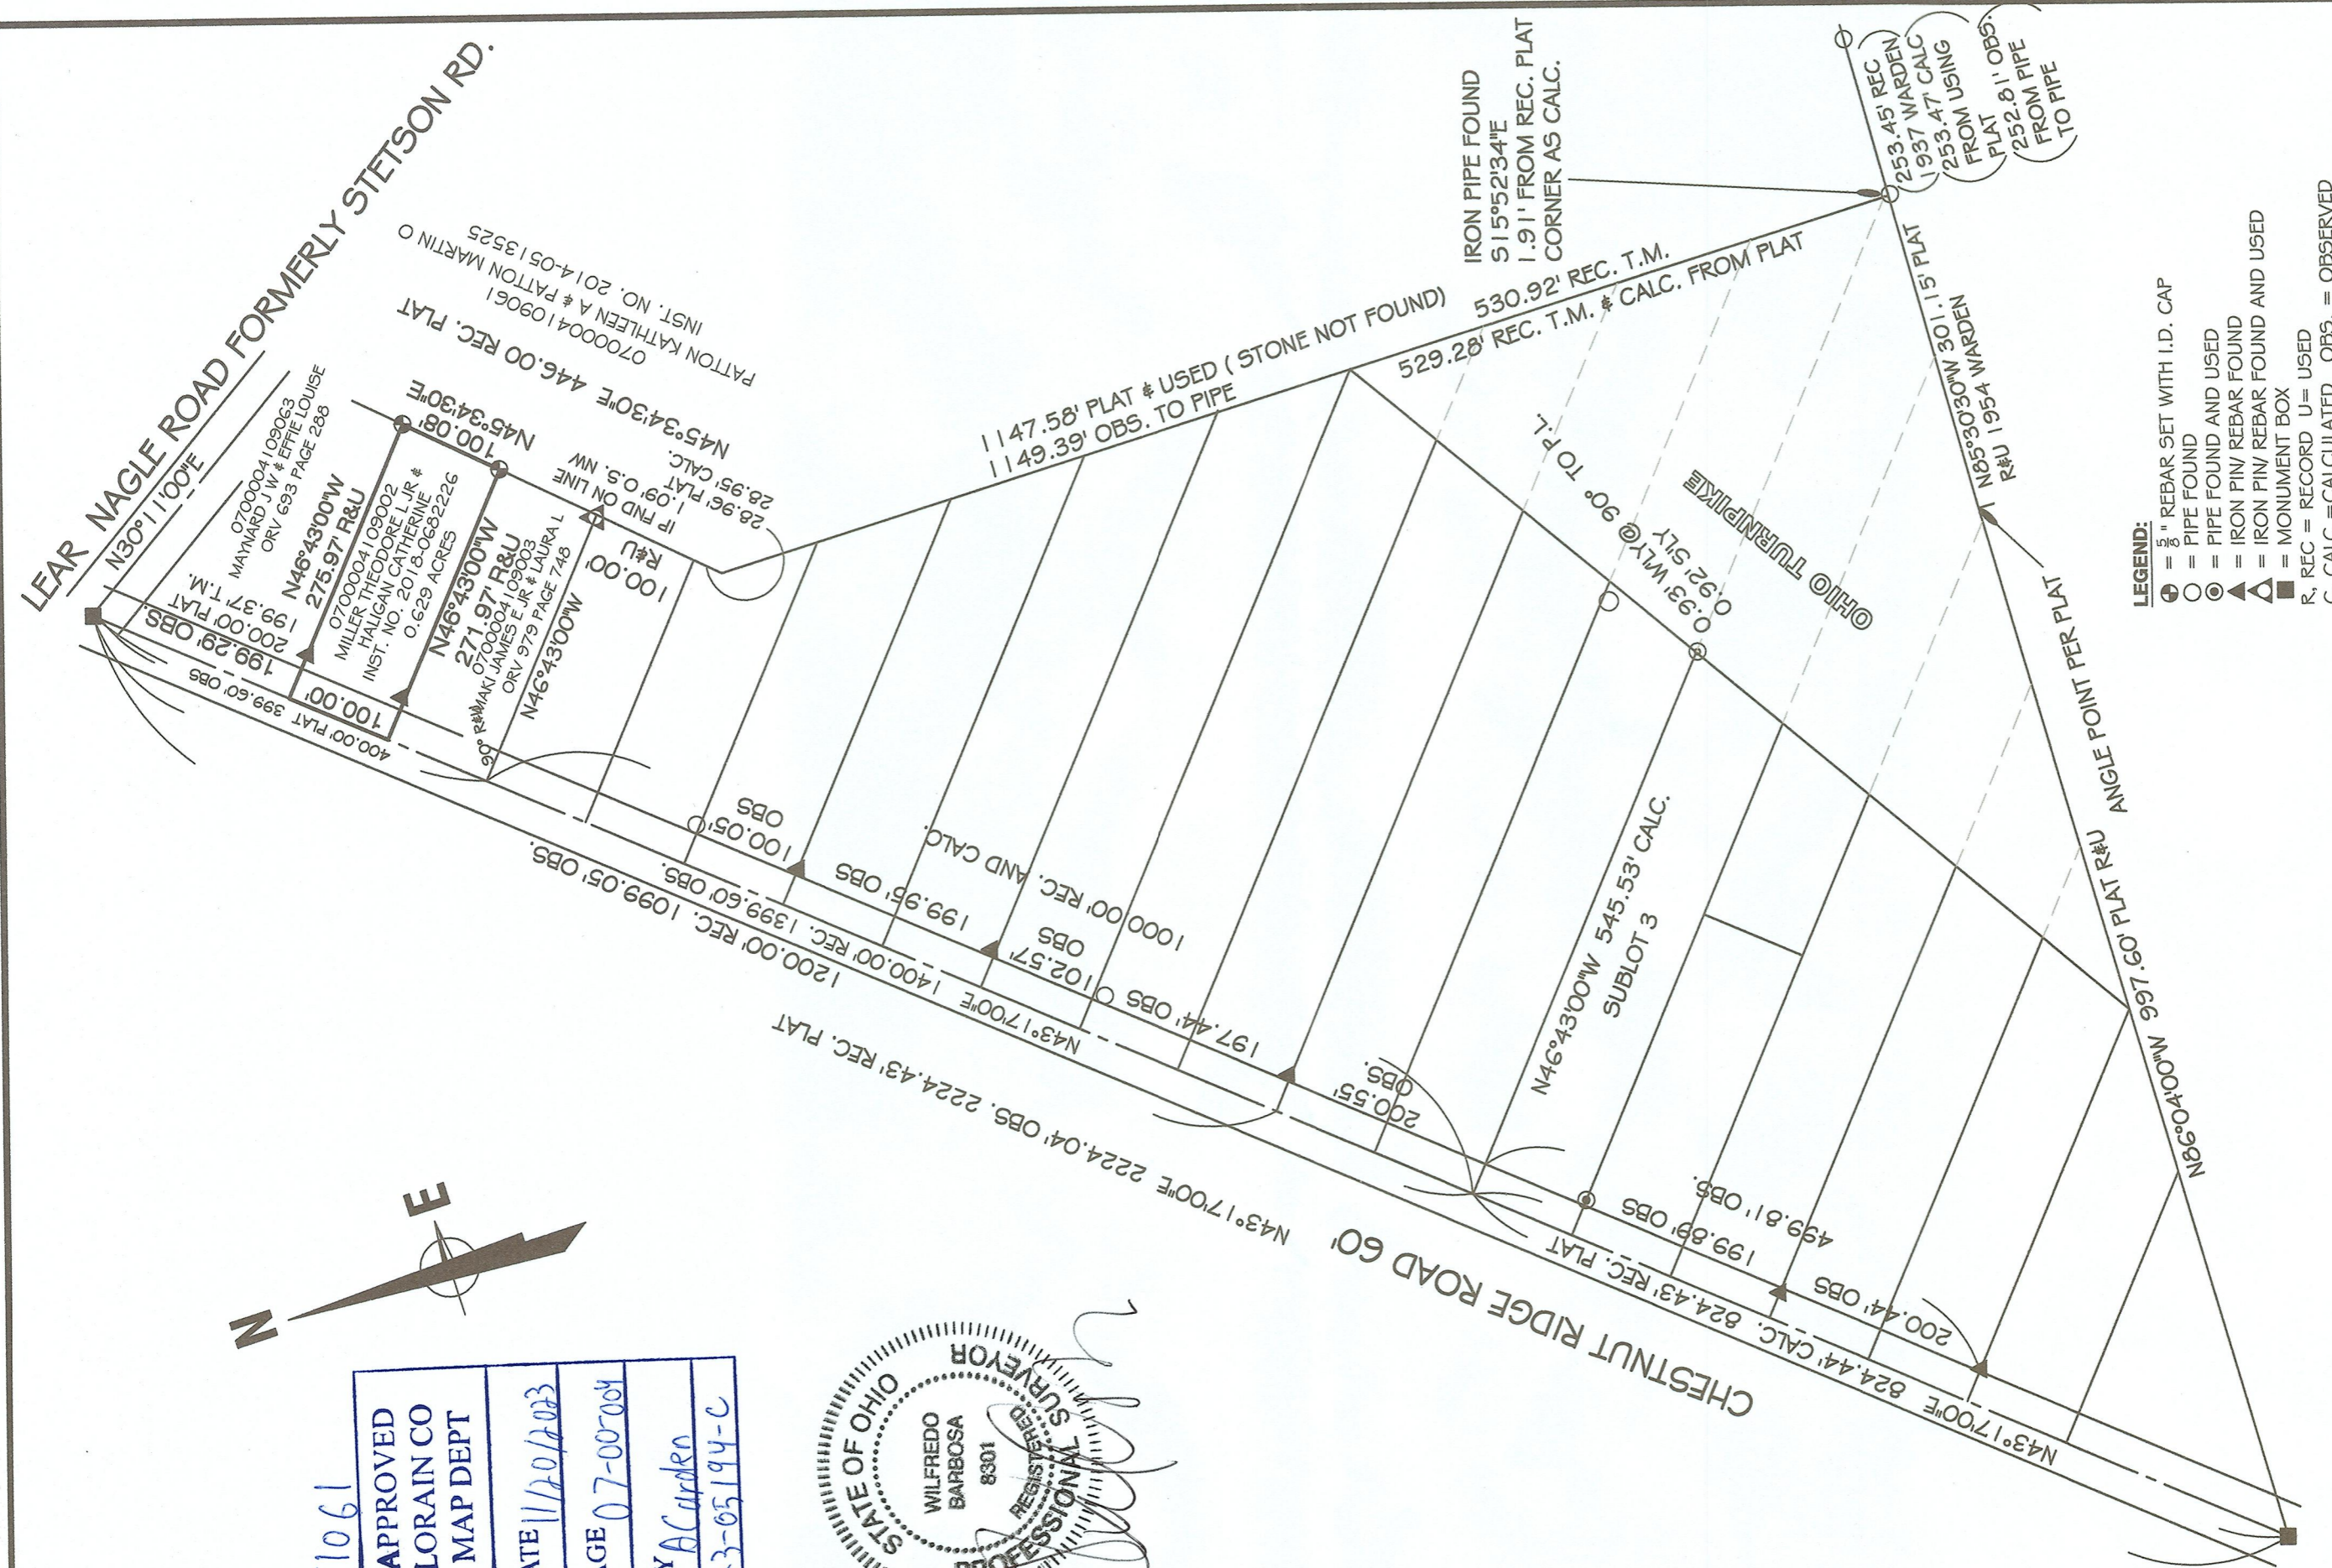
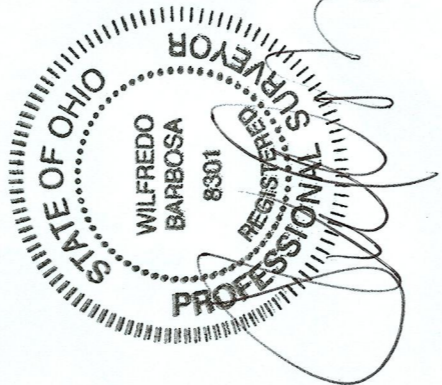


51061

APPROVED
LORAIN CO
MAP DEPT
DATE 11/20/2023
PAGE 07-00004
BY A. Curden
23-05194-C

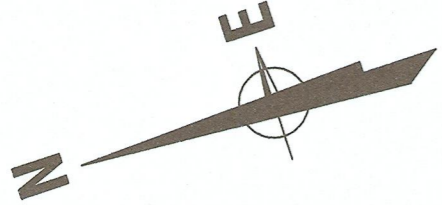

- LEGEND:**
- ⊕ = 5/8" REBAR SET WITH I.D. CAP
  - = PIPE FOUND
  - ⊙ = PIPE FOUND AND USED
  - ▲ = IRON PIN/ REBAR FOUND
  - △ = IRON PIN/ REBAR FOUND AND USED
  - = MONUMENT BOX
  - R, REC = RECORD U= USED
  - C, CALC = CALCULATED OBS. = OBSERVED

SCALE: 1" = 150'

PREPARED AT THE REQUEST OF:  
Catherine Halagan  
32851 Chestnut Ridge Road  
North Ridgeville, Ohio 44039

**Survey**  
07-00-004-109-002  
IN  
CITY OF NORTH RIDGEVILLE COUNTY OF LORAIN  
STATE OF OHIO

**BARBOSA AND ASSOCIATES LLC**  
5604 CASE ROAD  
NORTH RIDGEVILLE, OH 44039  
440 327-4776

ic/18/23 4/5/2020  
JOB No: 2023-9-2 REF JOB 2020-3-1  
CHECKED BY:WB  
SHEET 1 of 1