LEGEND:

- ◓ = 5/8" REBAR SET WITH I.D. CAP
- ○ = PIPE FOUND ⊗ = MAG SPIKE FOUND
- ● = PIPE FOUND AND USED
- ▲ = IRON PIN/ REBAR FOUND
- △ = IRON PIN/ REBAR FOUND AND USED
- ■ = MONUMENT BOX

APPROVED LORAIN CO MAP DEPT
DATE 2/22/24
PAGE 17-07-008
BY WR2
24-05252-C

51125

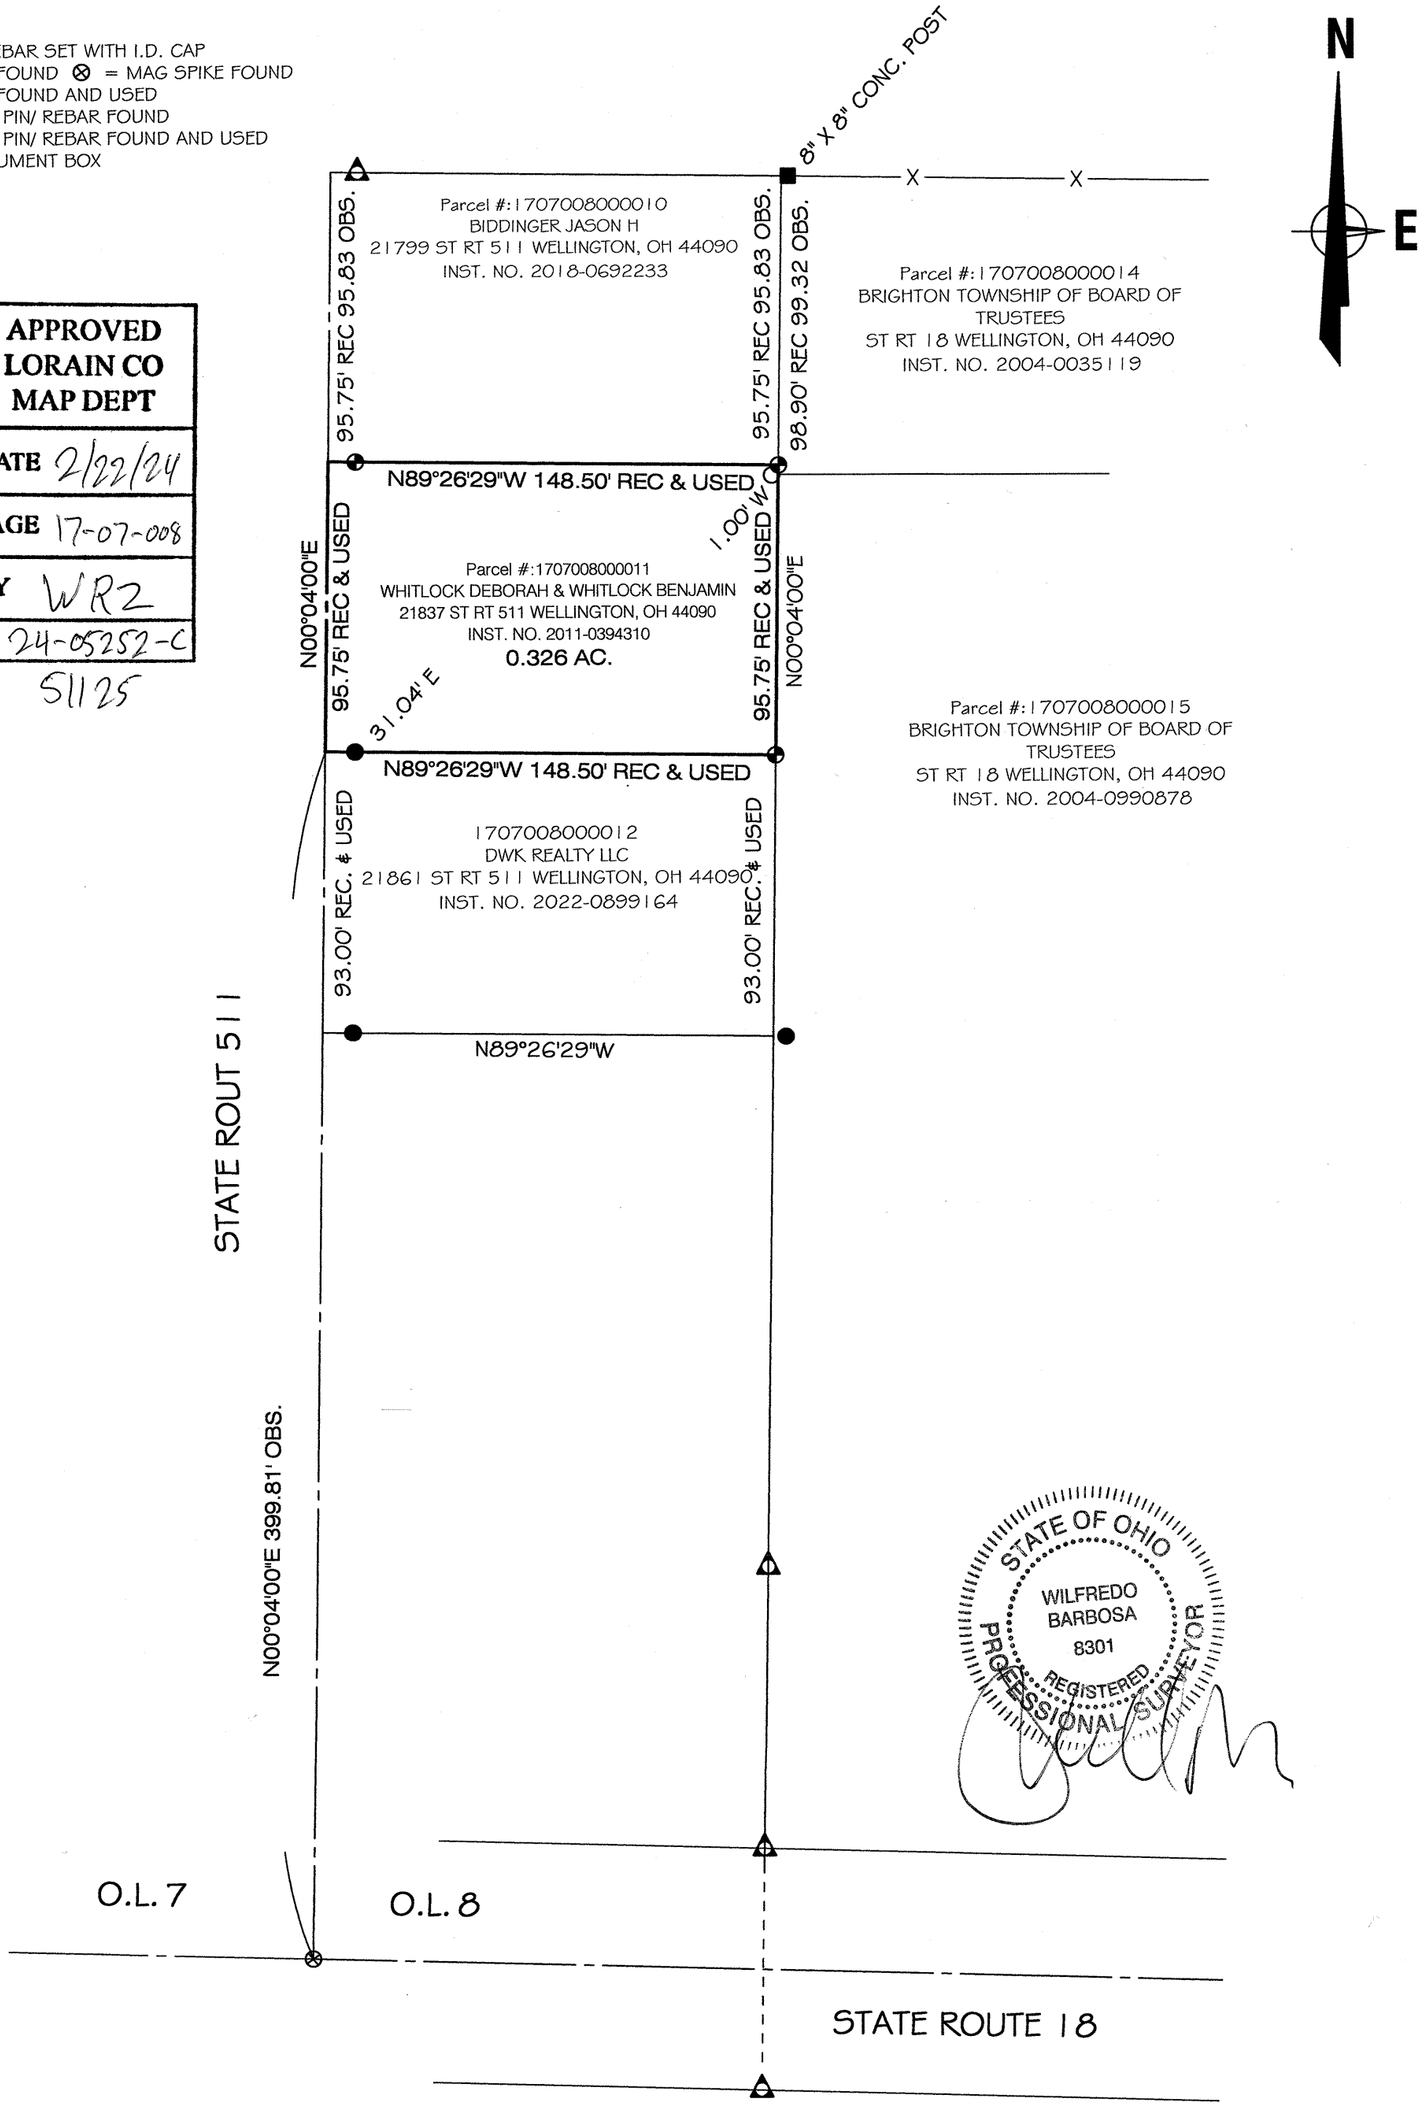

SCALE: 1" = 50'

0 50

25 100

PREPARED AT THE REQUEST OF:
DWK REALTY LLC

Survey Update

Part of Original Brighton Township Lot 8, Tract 7

COUNTY OF LORAIN STATE OF OHIO

BARBOSA AND ASSOCIATES LLC
5604 CASE ROAD
NORTH RIDGEVILLE, OH 44039
440 327-4776

2/12/2024	CHECKED BY:WB
JOB No: 2023-12-1	SHEET 1 of 1