


**LEGEND:**

- = 5/8" REBAR SET WITH I.D. CAP
- = PIPE FOUND
- = PIPE FOUND AND USED
- ▲ = IRON PIN/ REBAR FOUND
- △ = IRON PIN/ REBAR FOUND AND USED
- = MONUMENT BOX

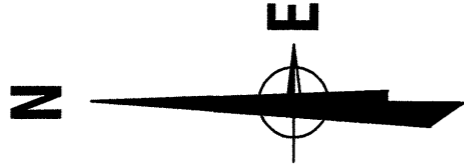

Parcel #: 1200011000028  
 GILLAMAN PROPERTIES LLC  
 19341 S BOONE RD  
 COLUMBIA STATION, OH 44028  
 INST. NO. 2020-0794705

N88°31'56"E 500.17' R&U

0.36' S  
 N88°31'56"E 346.00' R&U

Parcel #: 1200011000033  
 TIMKO ANDREW M & CAROL ANN  
 19531 S BOONE RD  
 NO. 2006-0150906

N88°31'56"E 346.00' R&U

N00°00'00"E 504.00' R&U

Parcel #: 1200011000035  
 SKOWRONEK MARY TRUSTEE  
 19555 S BOONE RD  
 INST. NO. 2000-0664119

N88°31'56"E 346.00' R&U

Parcel #: 1200011000036  
 WONKOVICH PATRICIA A TRUSTEE  
 19581 S BOONE RD  
 INST. NO. 2016-0596371

N88°31'56"E 346.00' R&U

Parcel #: 1200011000038  
 BALON STANISLAW TRUSTEE & ANNA M  
 19605 S BOONE RD  
 INST. NO. 2018-0657757

N88°31'56"E 346.00' R&U

24.37'

N00°00'00"E 223.90' OBS

N88°34'12"E  
 100.00' R&U

P.O.B

30.01'

N61°45'34"W 279.16' CALC.  
 O.17' E

Parcel #: 1200011000041  
 DOBSON MICHAEL G & SHARON L  
 19703 S BOONE RD INST. NO.  
 2018-0664201

Parcel #: 1200011000040  
 BRENNAN PATRICIA A  
 19733 S BOONE RD  
 INST. NO. 2007-0225985

O.13' N  
 O.16' E

SOUTH BOONE ROAD 60'

N00°00'00"W 820.22' CALC.

N88°34'12"E 346.00' R&U  
 LEANING  
 BASE  
 0.30' E  
 STEEL POST BASE  
 ON LINE  
 80.72' FROM C.L.

APPROVED
LORAIN CO
MAP DEPT
DATE 3/11/24
PAGE 12-00-011
BY WRZ
24-05258-C
5/132

P.O.C

N88°34'12"E 346.00' R&U

BOSTON ROAD 60'

SCALE: 1" = 120'



PREPARED AT THE REQUEST OF:  
 JORDAN LENERTH

**SURVEY**

Parcel #: 1200011000042  
 LENNERTH JORDAN TRUSTEE  
 19625 S BOONE RD COLUMBIA STATION, OH 44028  
 ORIGINAL COLUMBIA TOWNSHIP LOT 11  
 COLUMBIA TOWNSHIP COUNTY OF LORAIN  
 STATE OF OHIO


BARBOSA AND ASSOCIATES LLC

5604 CASE ROAD  
 NORTH RIDGEVILLE, OH 44039  
 440 327-4776

9/14/2023

JOB No: 2023-5-10

SHEET 1 of 1

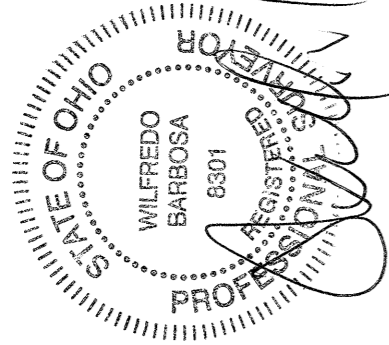

Parcel #: 1200011000042  
 LENNERTH JORDAN TRUSTEE  
 19625 S BOONE RD  
 COLUMBIA STATION, OH 44028  
 INST. NO. 2019-0702224  
 14.00 ACRES REC.

13.986 ACRES CALC.

Parcel #: 1200011000002  
 BAILEY JOHN C & BAILEY JEAN W  
 5 BOONE RD COLUMBIA STATION, OH 44028  
 INST. NO. 2021-084685

N88°34'12"E 500.16' CALC.  
 O.15' W

Parcel #: 1200011000025  
 LASCH MICHAEL A & LASCH MARK  
 REAR LAND COLUMBIA STATION, OH 44028  
 INST. NO. 2022-0895683

Parcel #: 1200011000021  
 SCHOLTZ JEFFREY H & DIANE L  
 REAR LAND COLUMBIA STATION, OH 44028  
 INST. NO. 1997-0471613

Parcel #: 1200011000019  
 BARTEL MARK A  
 REAR LAND COLUMBIA STATION, OH 44028  
 INST. NO. 2018-0674754

Parcel #: 1200011000017  
 TIBBS CHARLES T & TIBBS REBECCA  
 REAR LAND COLUMBIA STATION, OH 44028  
 INST. NO. 2018-0692169

0.78' W FROM C.L.  
 35.08' FROM C.L.

USED FOR LINE  
 31.37' FROM C.L.

N88°34'12"E 500.16' R&U

N88°34'12"E 346.00' R&U

P.O.C