

Scale: 1" = 20'
September, 2024


MAP OF SURVEY

PREPARED FOR

VAUGHN

Situated in the Township of Elyria, County of Lorain and State of Ohio
and known as being part of Elyria Township Lot No. 37, West of the Black River

RAMBLER AVENUE 60'

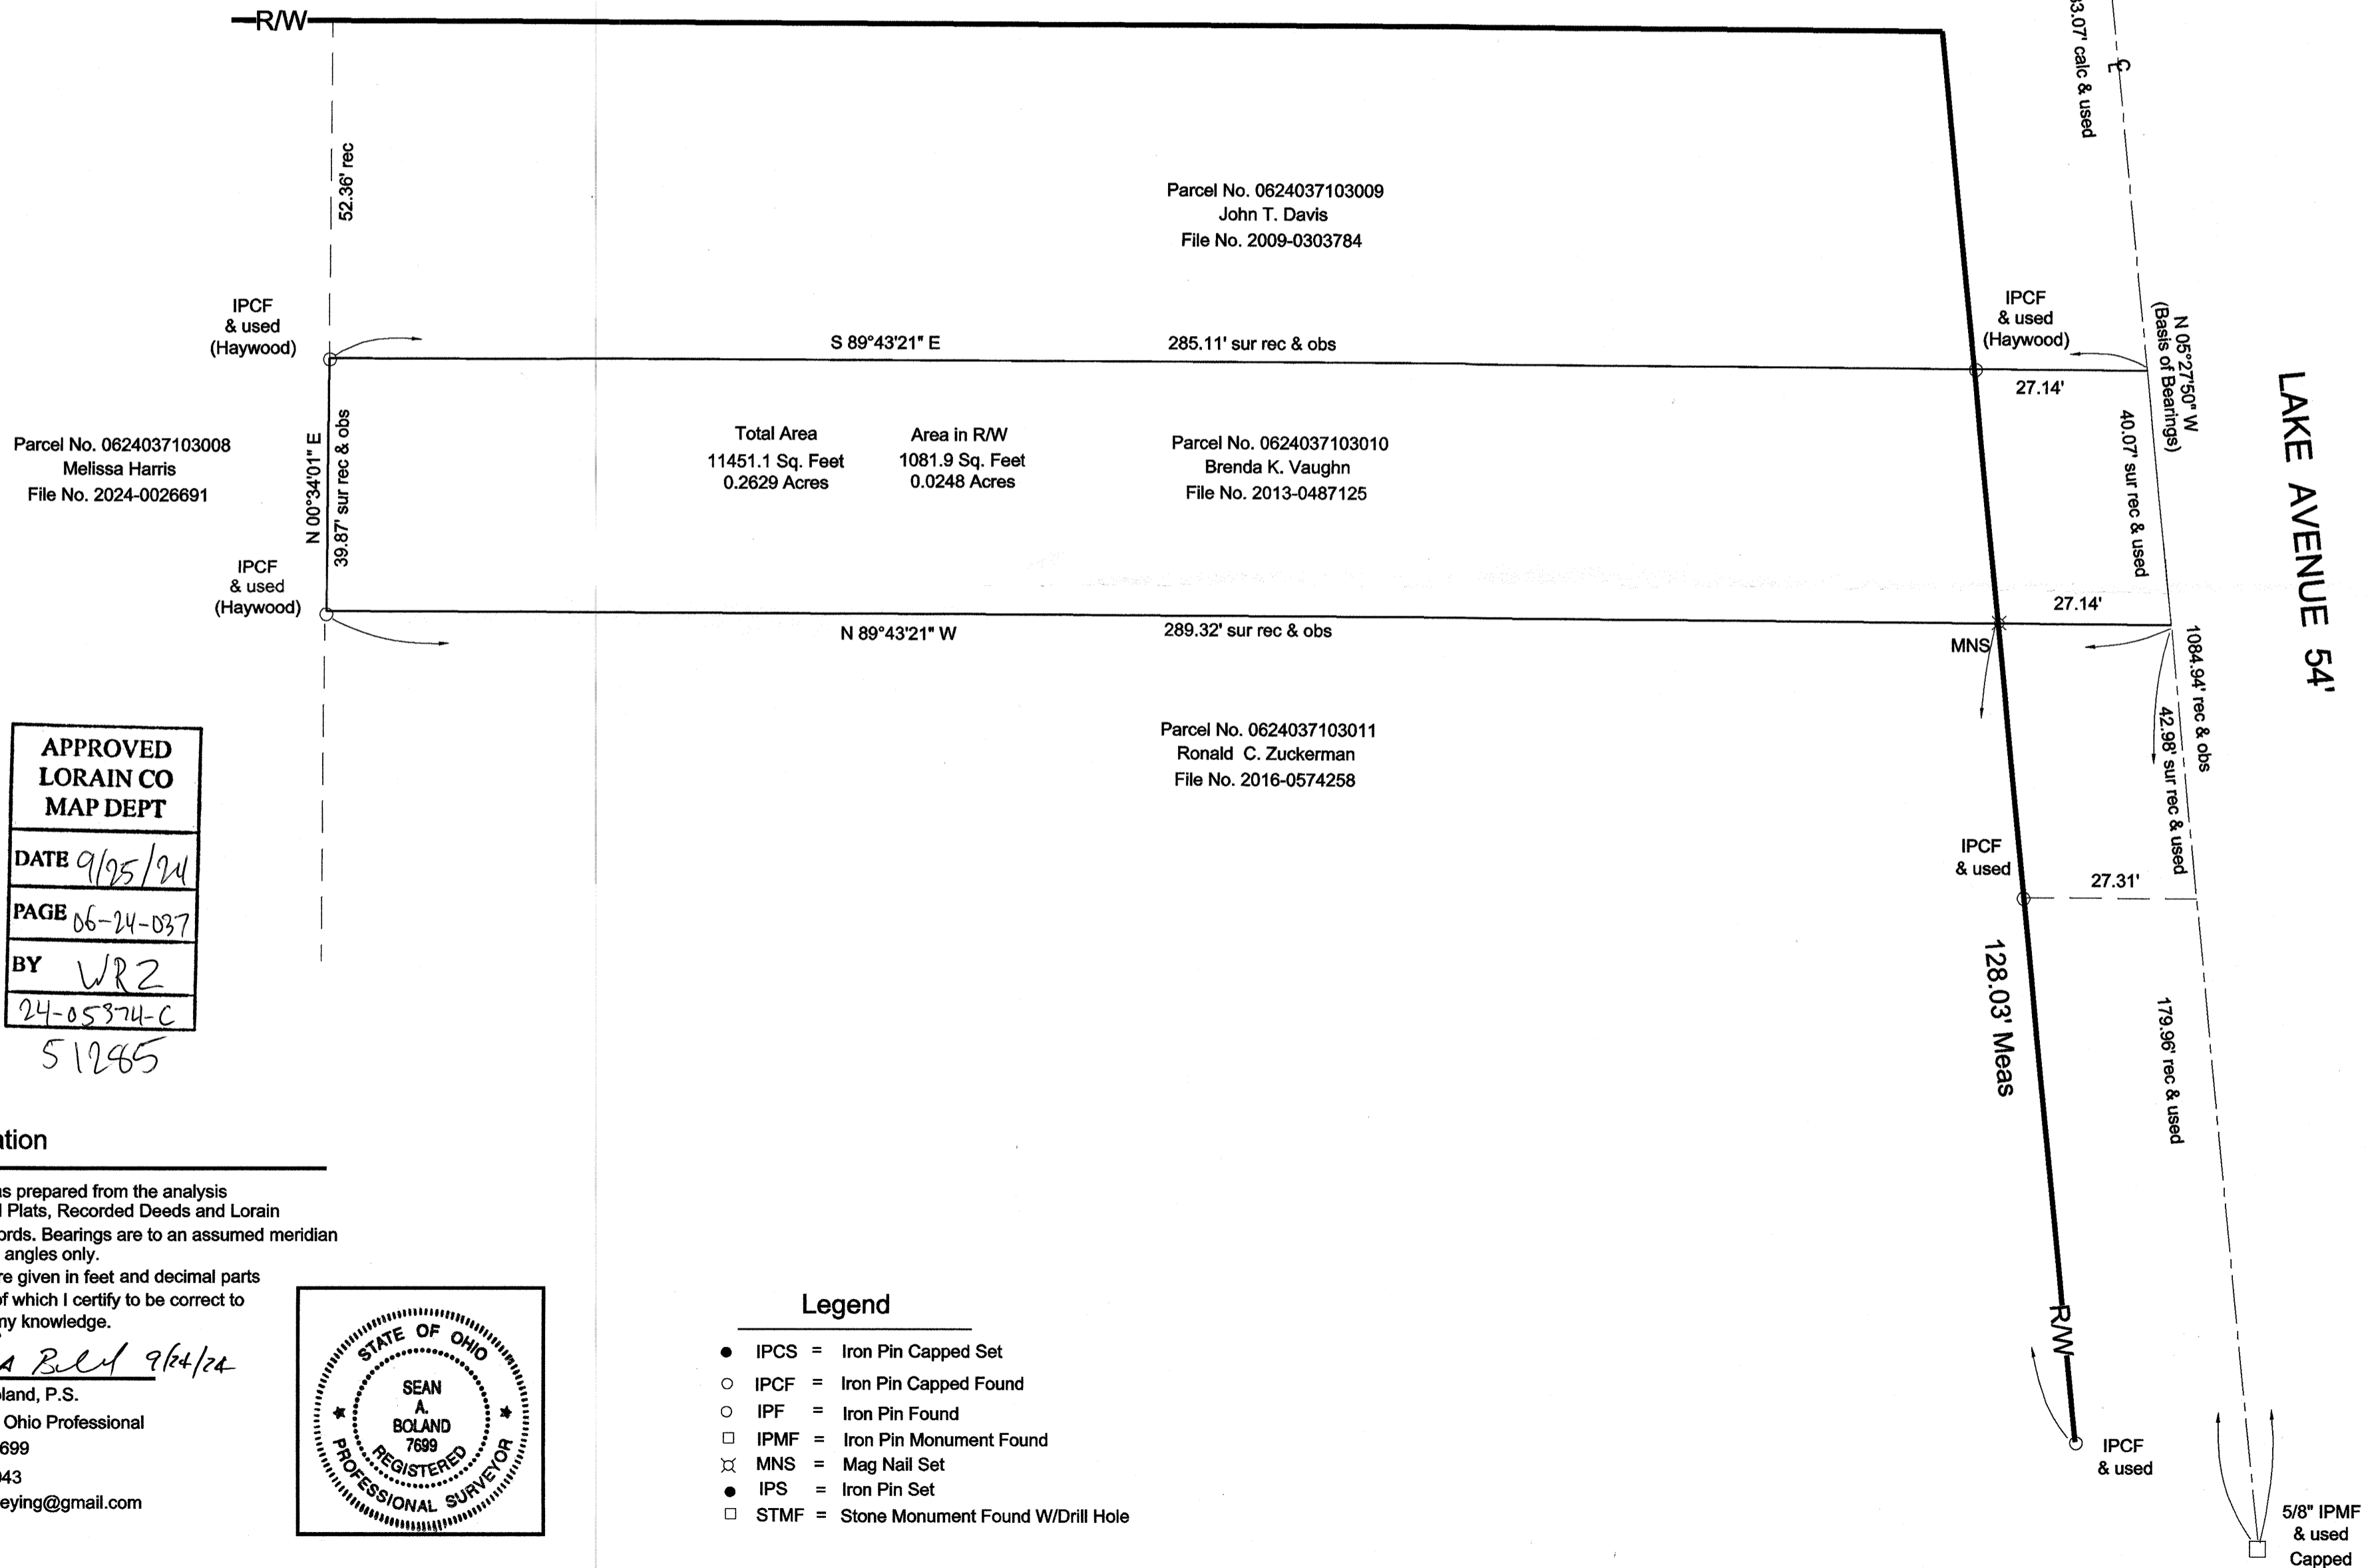

APPROVED
LORAIN CO
MAP DEPT

DATE 9/25/24

PAGE 06-24-037

BY WRZ


24-05374-C

51245

Certification

This Plat was prepared from the analysis of Recorded Plats, Recorded Deeds and Lorain County Records. Bearings are to an assumed meridian and indicate angles only. Distances are given in feet and decimal parts thereof. All of which I certify to be correct to the best of my knowledge.

Sean A. Boland 9/24/24
Sean A. Boland, P.S.
Registered Ohio Professional Surveyor 7699
440 785-2943
bolandsurveying@gmail.com

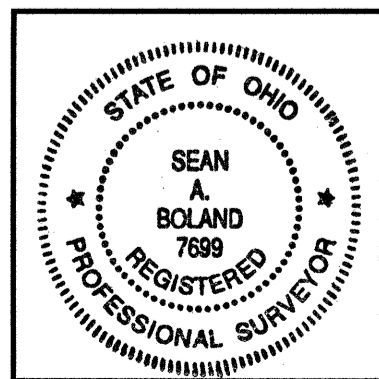

LAKE AVENUE 54'

5/8" IPMF & used Capped