

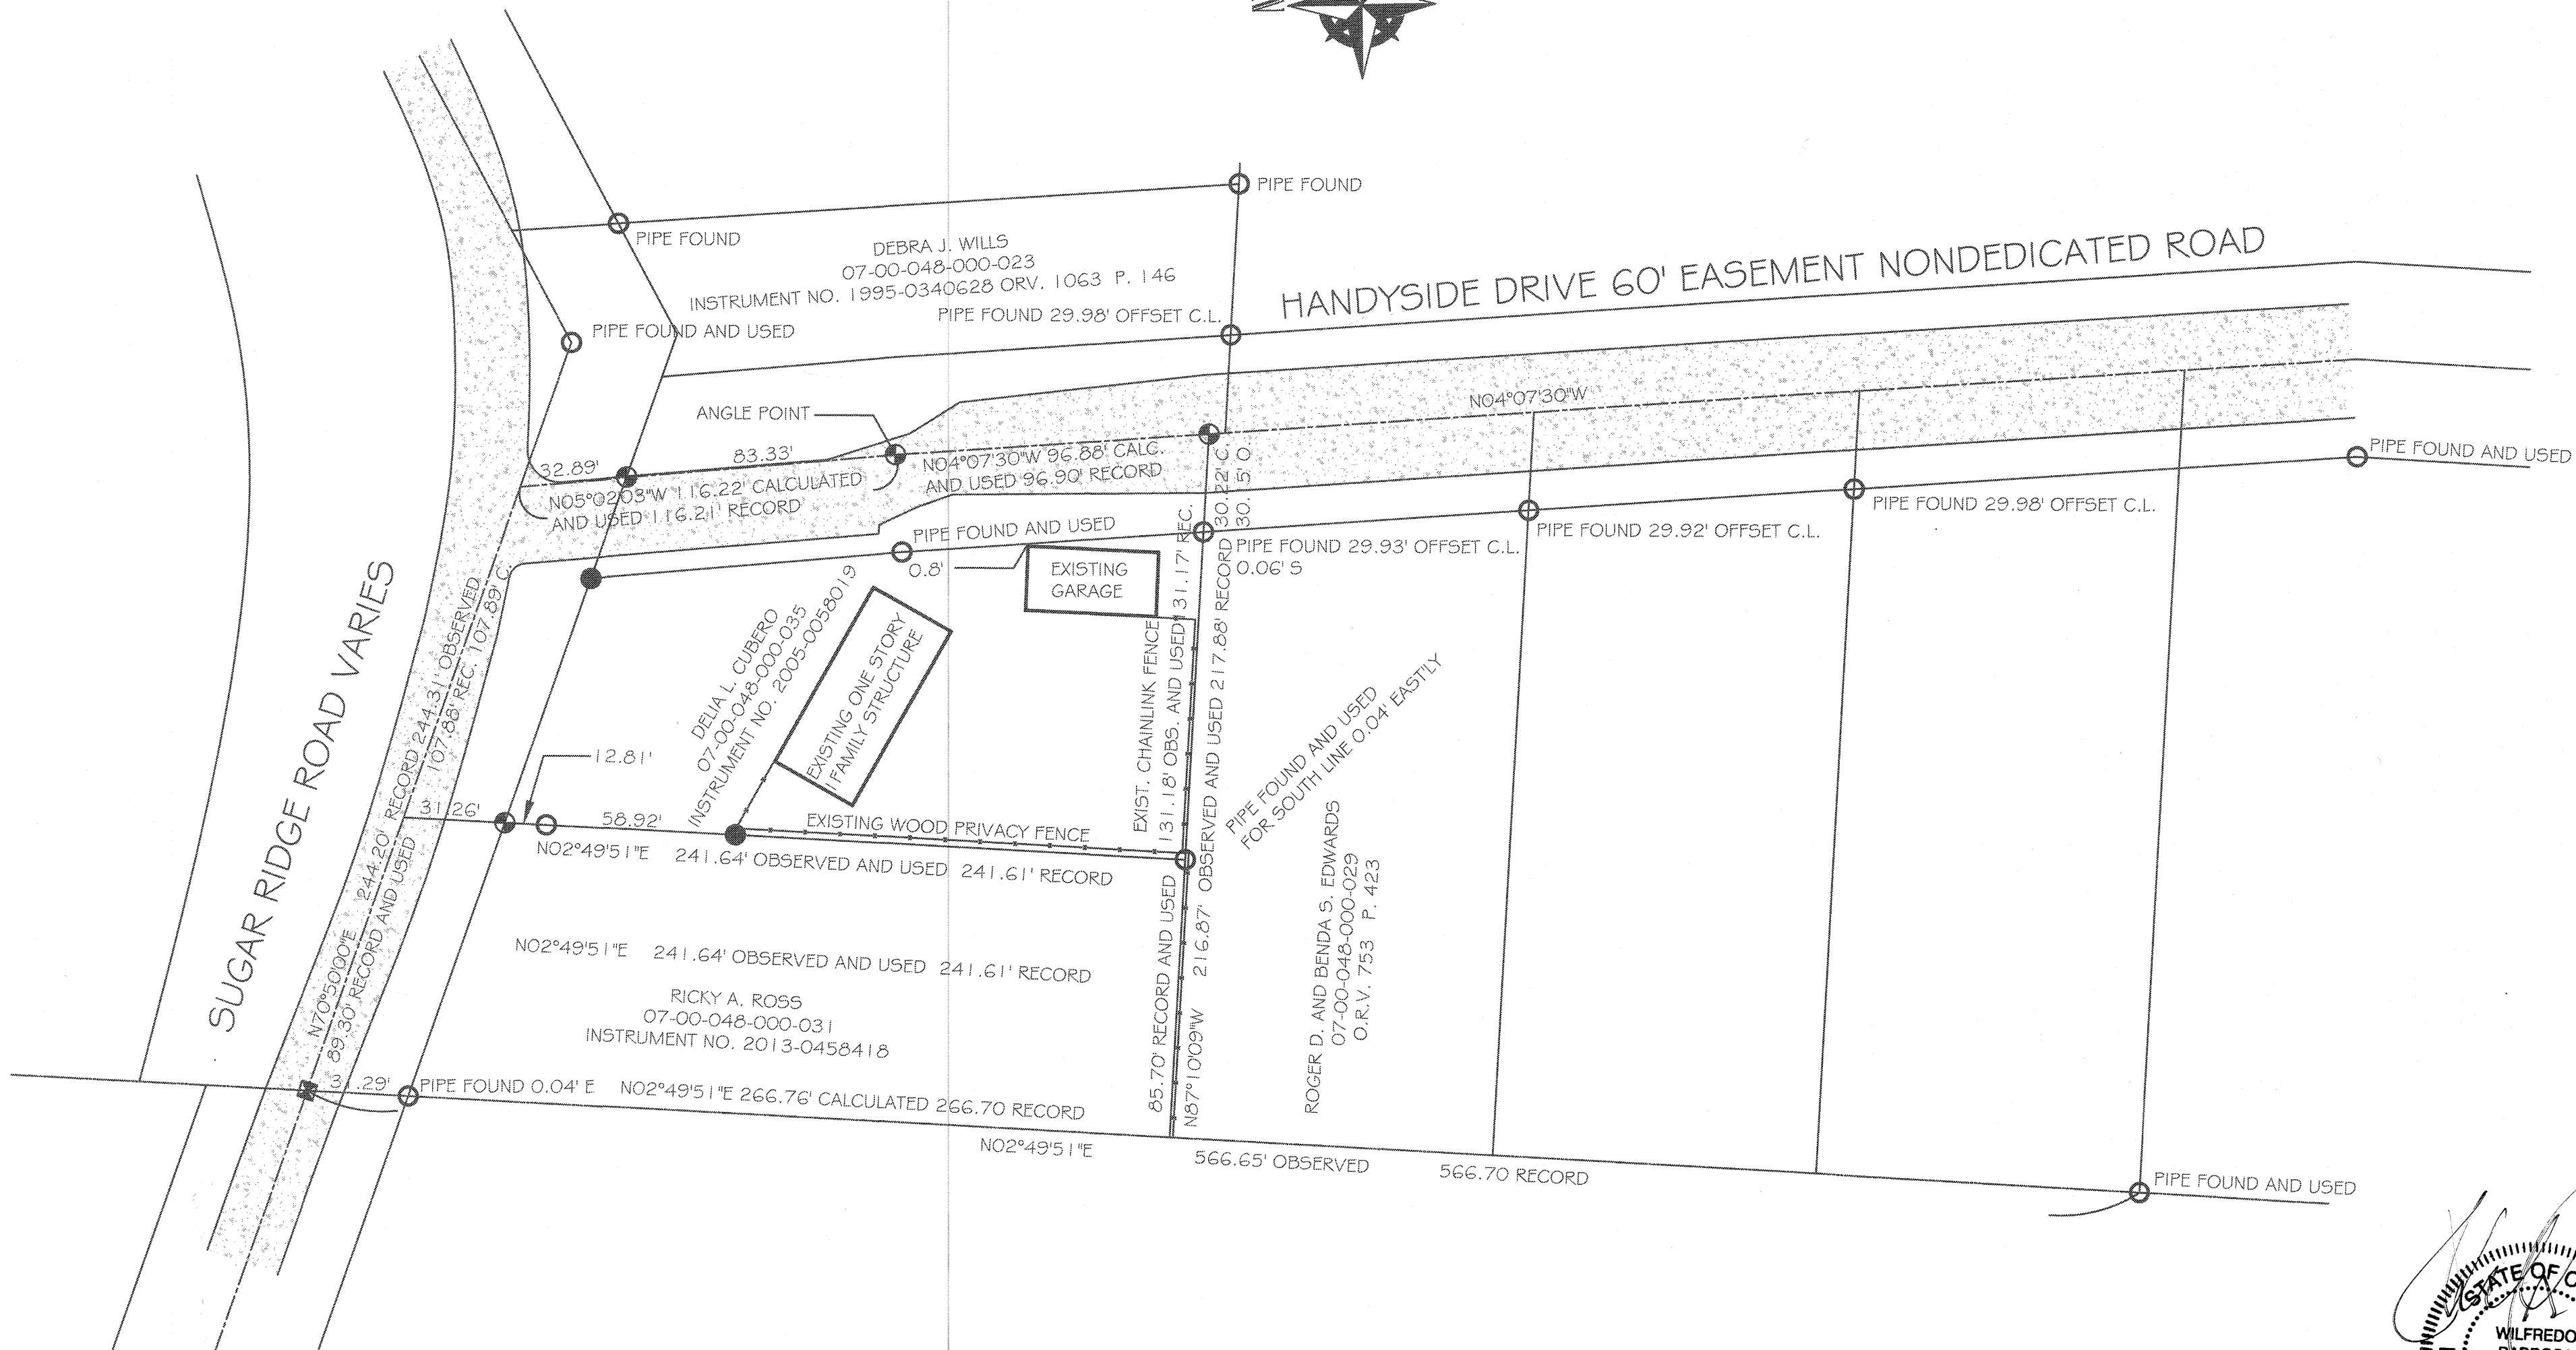
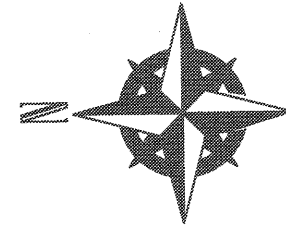


SURVEY
OF PART OF
ORIGINAL RIDGEVILLE TOWNSHIP LOT 48
CITY OF NORTH RIDGEVILLE COUNTY OF LORAIN STATE OF OHIO

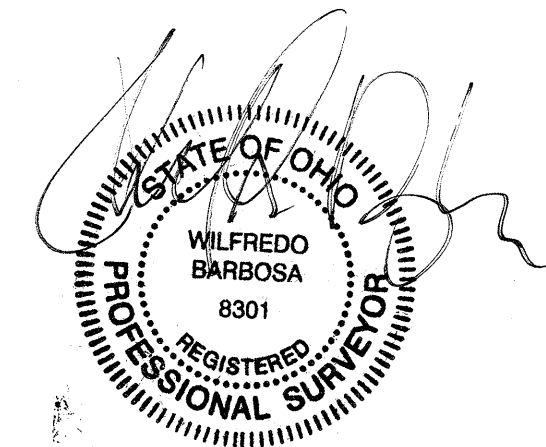

- LEGEND:
- 1. = MONUMENT BOX WITH IRON PIPE FOUND
 - 2. = PIPE FOUND
 - 3. = 5/8" IRON PIN SET WITH CAP THAT READS BARBOSA AND ASSOCIATES
 - 4. = MAG NAIL OR MAG SPIKE OR PK NAIL SET
 - 5. O. OR OBS. = OBSERVED
 - 6. REC. = RECORD FROM DEED OR SURVEY PLAT
 - 7. C. OR CALC. = CALCULATED

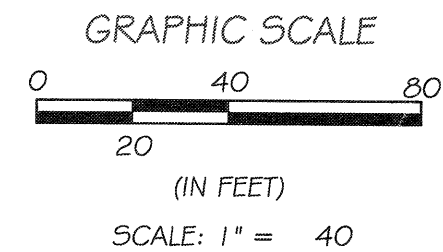

DATE: JULY 13, 2016

CUBERO RESIDENCE DELIA L. CUBERO 39425 SUGAR RIDGE ROAD NORTH RIDGEVILLE, OHIO 44039	BARBOSA AND ASSOCIATES LLC 5604 CASE ROAD NORTH RIDGEVILLE, OH 44039
DRAWN BY: WB	CHECKED BY: WB
JOB No: 2016-6-2	SHEET 1 of 1