

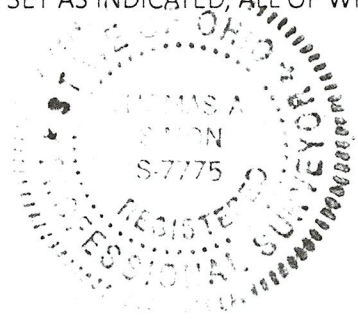


DIMENSIONS SHOWN ON THIS PLAT ARE EXPRESSED IN FEET AND DECIMAL PARTS THEREOF. ALL BEARINGS ARE TO AN ASSUMED MERIDIAN AND ARE USED TO DESCRIBE ANGLES ONLY. PERMANENT MONUMENTS WERE FOUND OR SET AS INDICATED, ALL OF WHICH I CERTIFY TO BE CORRECT.

Thomas A. Simon
THOMAS A. SIMON, REGISTERED
PROFESSIONAL SURVEYOR NO. S-7775

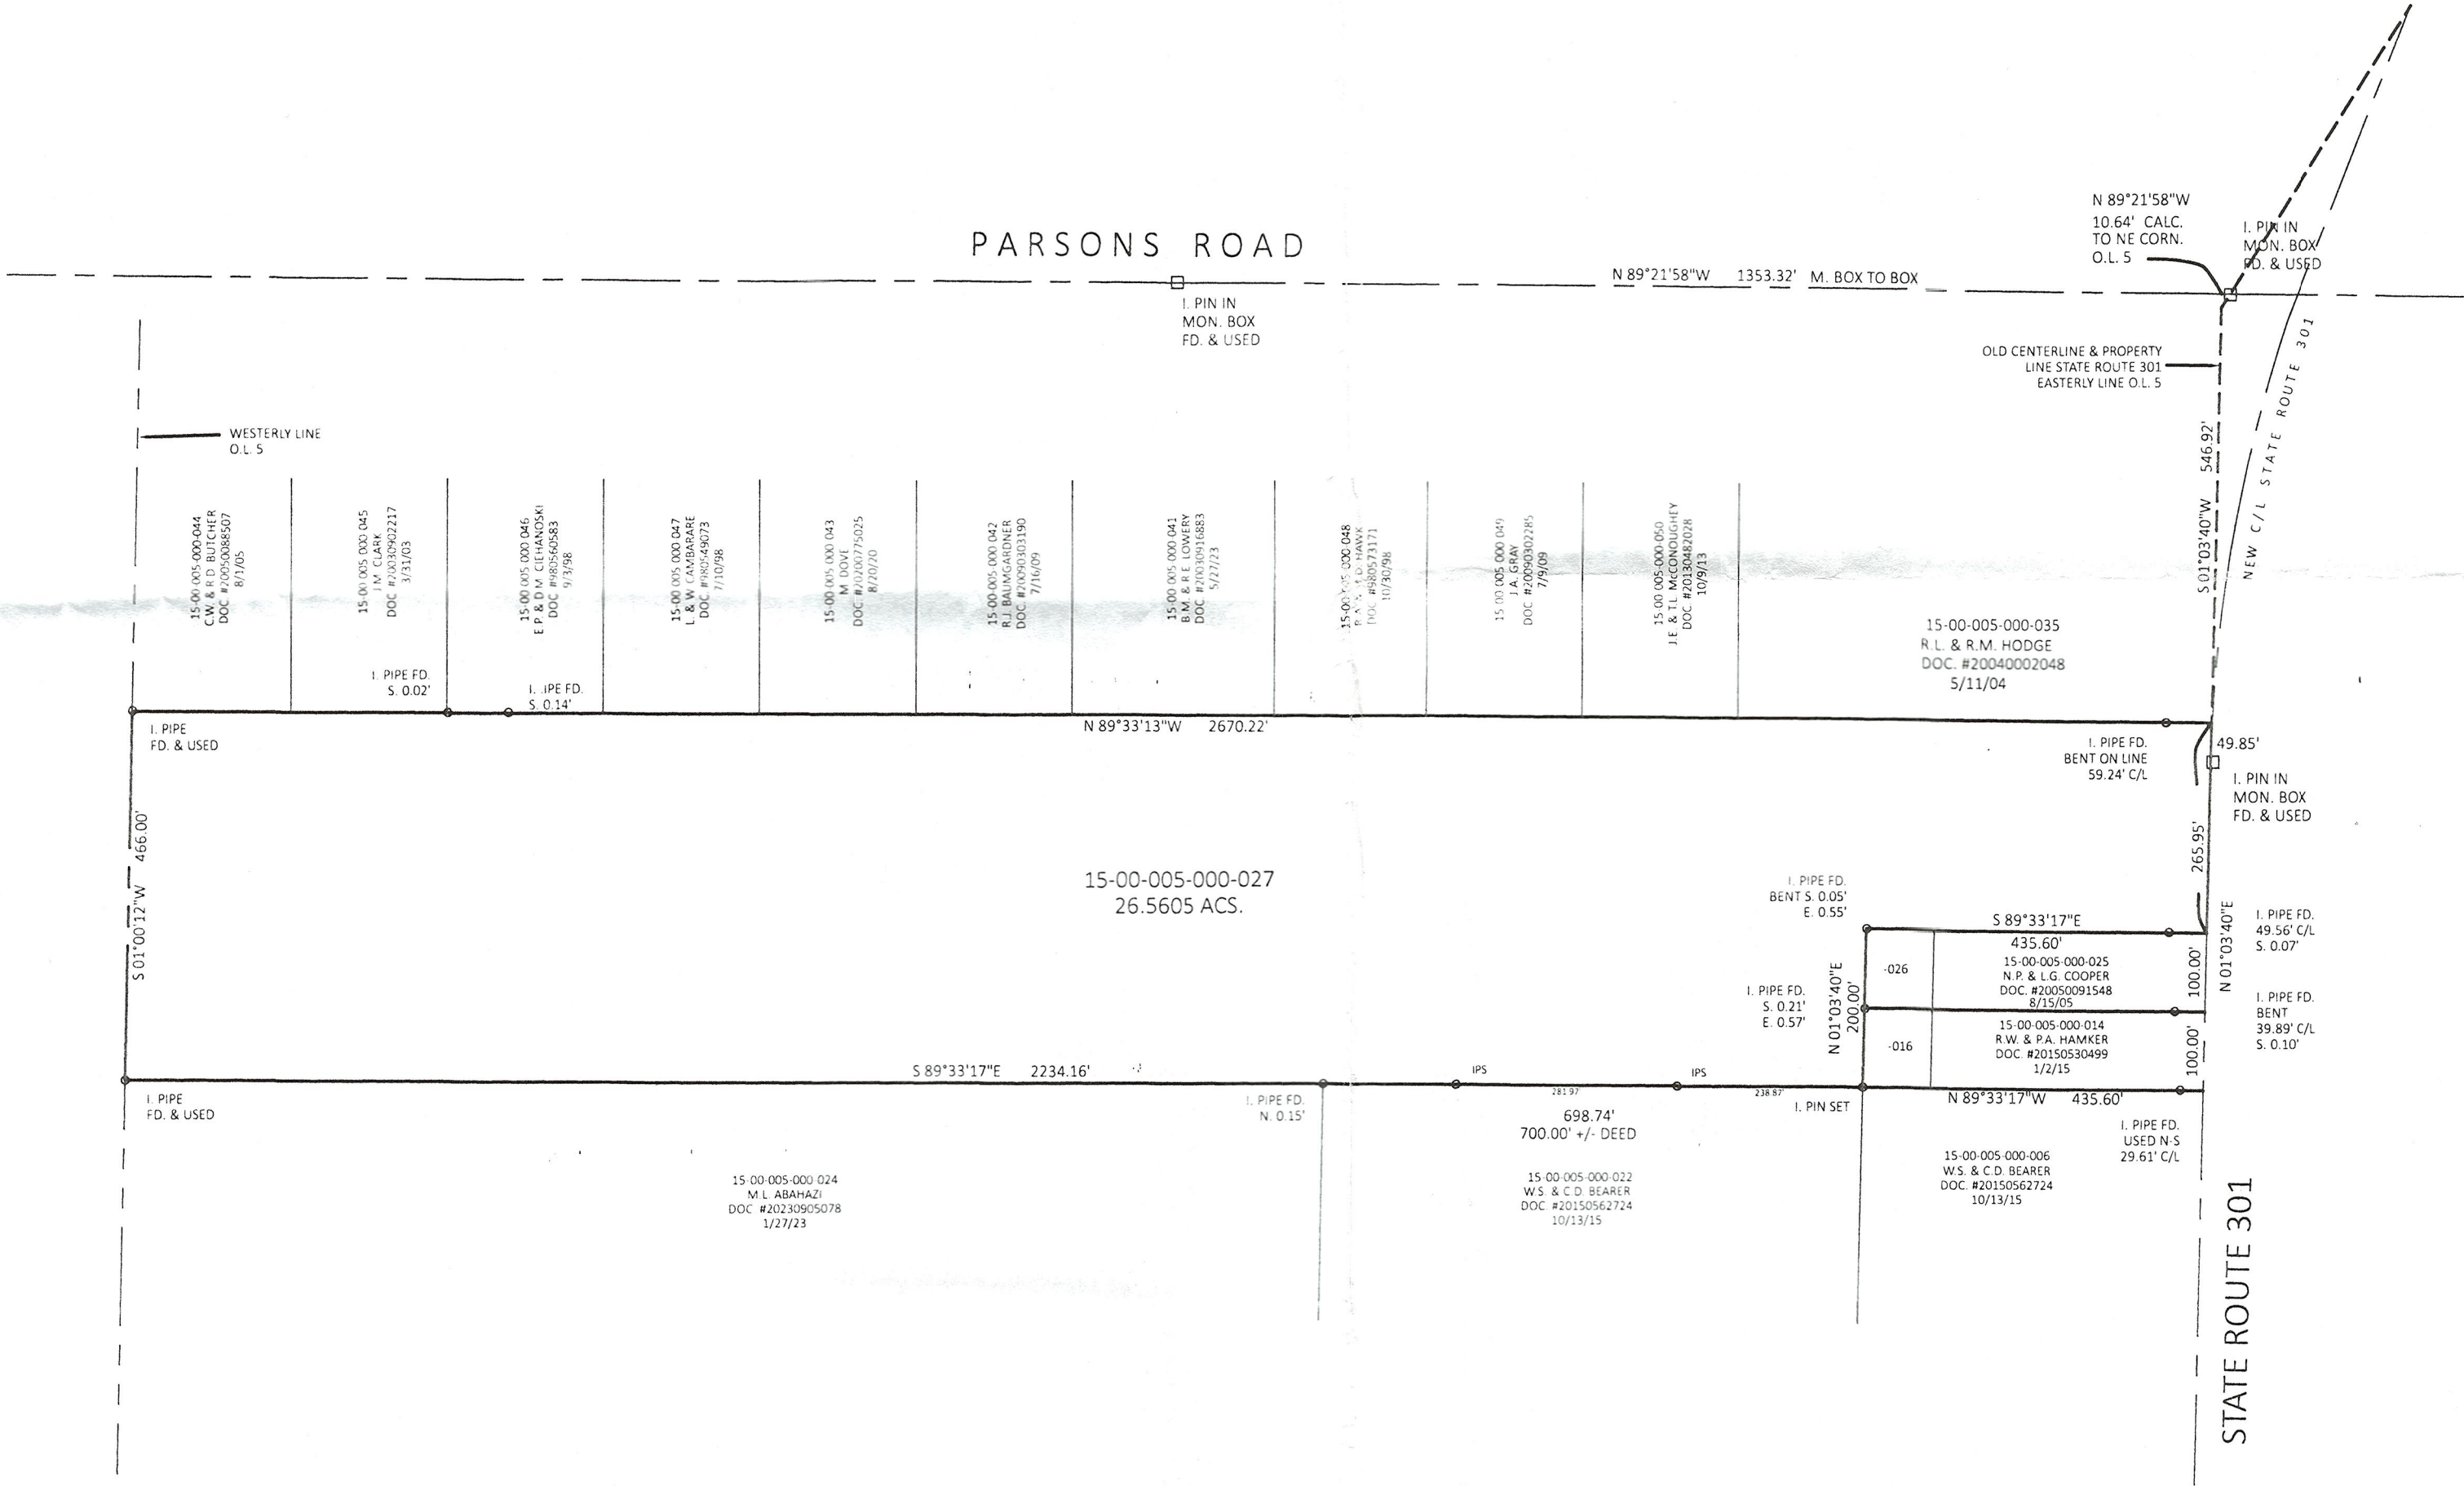

BASIS OF BEARINGS IS THE CENTERLINE OF PARSONS ROAD
(NORTH 89°21'58" WEST). IRON PINS SET ARE 3/8" DIAMETER,
30" LONG WITH PLASTIC CAPS "T. SIMON, S-7775

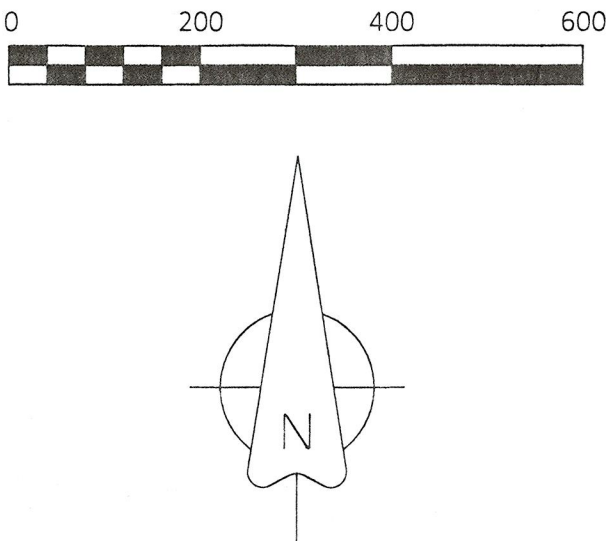

51408
APPROVED
LORAIN CO
MAP DEPT
DATE 3/12/2025
PAGE 15-001-005
BY ACarden
#25-05468-C

PLAT OF BOUNDARY SURVEY
FOR
CHARLES L. SCHECKEL, TRUSTEE
BEING KNOWN AS PART OF
ORIGINAL LAGRANGE TOWNSHIP LOT NO. 5
COUNTY OF LORAIN STATE OF OHIO
JULY, 2024 SCALE: 1" = 200'

THOMAS SIMON & ASSOCIATES, INC.
PROFESSIONAL LAND SURVEYORS
150 SOUTH OLIVE STREET
ELYRIA, OHIO 44035
(440) 327-2925
TASIMON@WINDSTREAM.NET