

BARRES ROAD 60'

N38°46'08"W
217.35' OBS

N30°41'09"W
3101.40' OBS

N121°04'10"W
618.76' OBS
80.04' R&C

Parcel #:0700029000196
SCHULTZ THOMAS S III & SCHULTZ RUBY L
6345 STONEY RIDGE RD
INST. NO. 2014-0497590

N22°07'13"W
89.90' CALC.
NEW CL USED

N88°44'20"W 306.24'

27.03'
OBS.

212.17' R&U

94.19' R&U

0.20' N

Parcel #:0700029000020
HUGHES RAYMOND M JR
6365 STONEY RIDGE RD
INST. NO. 2008-0260832

CONSOLIDATION = 1.296 AC.

Parcel #:0700029000021
Owner:HUGHES RAYMOND M JR
STONEY RIDGE RD NORTH
INST. NO. 2008-0260832

26.96'
OBS.

N88°44'20"W 217.71' CALC. 217.77' REC.

Parcel #:0700029000060
HOOVER CHRISTOPHER A
6401 STONEY RIDGE RD NORTH
INST. NO. 2015-0564186

STONEY RIDGE ROAD 60'



APPROVED
LORAIN CO
MAP DEPT

DATE 4/21/25

PAGE 07-00-019

BY WRZ

25-05001

51432



BLOCK "U"
HAMPTON PLACE SUBDIVISION NO. 06
PLAT VOL. 111 PAGE 74

PROPERTY ADDRESS:
6365 STONEY RIDGE ROAD
NORTH RIDGEVILLE, OHIO

BARBOSA AND ASSOCIATES LLC

5604 CASE ROAD
NORTH RIDGEVILLE, OH 44039
440 327-4776


PREPARED AT THE REQUEST OF:
Raymond M. Hughes

10/9/2024

JOB No: 2024-8-2

SHEET 1 of 1

GRAPHIC SCALE

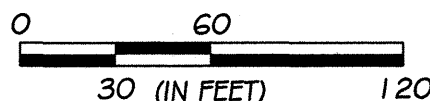

SCALE: 1" = 60'

SURVEY

PART OF ORIGINAL RIDGEVILLE TWP LOT 29
CITY OF NORTH RIDGEVILLE
COUNTY OF LORAIN
STATE OF OHIO

LEGEND:

● = 5/8" REBAR SET WITH I.D. CAP
○ = PIPE FOUND ● = PIPE USED
▲ = IRON PIN/ REBAR FOUND
▲ = IRON PIN/ REBAR FOUND AND USED
■ = MONUMENT BOX ○ = SPIKE ☒ = FENCE POST
R, REC = RECORD U = USED
C, CALC = CALCULATED T.M. = TAX MAP
OBS = OBSERVED CL = CENTERLINE