



PARSONS ROAD 60'

CARLISLE TWP.

LAGRANGE TWP.

N86°29'20"W 200.00' R.U.

N86°29'20"W 200.00' R.U.

N04°12'00"E 300.00' R.U.

N04°12'00"E 300.00' R.U.

1500009000016
SLUSHER DENISE L
39449 PARSONS RD GRAFTON OH 44044
INST. NO. 2006-0136723
1.377 ACRES CALC.


1500009000020
SLUSHER DENISE L
PARSONS RD GRAFTON OH 44044
INST. NO. 2006-0136723

1500009000029
WEST KELLY A & OIMOEN STEVEN C
39495 PARSONS RD GRAFTON OH 44044
INST. NO. 2014-0514545

1500009000021
SLUSHER DENISE L
REAR LAND GRAFTON OH 44044
INST. NO. 2006-0136723

51436

APPROVED LORAIN CO MAP DEPT
DATE 4/24/2025
PAGE 15-00-009
BY B. Baumhauer
25-05444-C

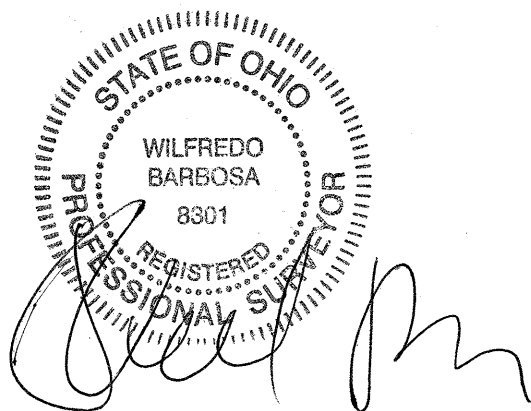


LEGEND:

- ⊙ = 3/8" REBAR SET WITH I.D. CAP
- = PIPE FOUND
- = PIPE FOUND AND USED
- ▲ = IRON PIN/ REBAR FOUND
- ▲ = IRON PIN/ REBAR FOUND AND USED
- = MONUMENT BOX
- ⊕ = DRILL HOLE FOUND
- C.L. = CENTERLINE

- O, OBS = OBSERVED
- C, CALC = CALCULATED
- R, REC = RECORD
- I.N. = INSTRUMENT NUMBER
- ORV = OFFICIAL RECORD VOLUME
- O.L. = ORIGINAL LOT
- PCL = PARCEL
- AC = ACREAGE

SCALE: 1" = 50'

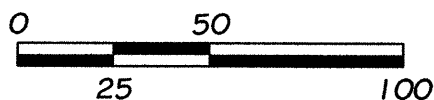

PREPARED AT THE REQUEST OF:
Denise Slusher

Survey

OF PART OF
ORIGINAL LAGRANGE TOWNSHIP LOT NO. 9
TOWNSHIP OF LAGRANGE COUNTY OF LORAIN
STATE OF OHIO

BARBOSA AND ASSOCIATES LLC

5604 CASE ROAD
NORTH RIDGEVILLE, OH 44039
440 327-4776

APRIL 23, 2025

CHECKED BY:WB

JOB No: 2025-4-1

SHEET 1 of 1