
BOUNDARY SURVEY

FOR

JEREMY HORNING

SITUATED IN THE TOWNSHIP OF HENRIETTA, COUNTY OF LORAIN, STATE OF OHIO,

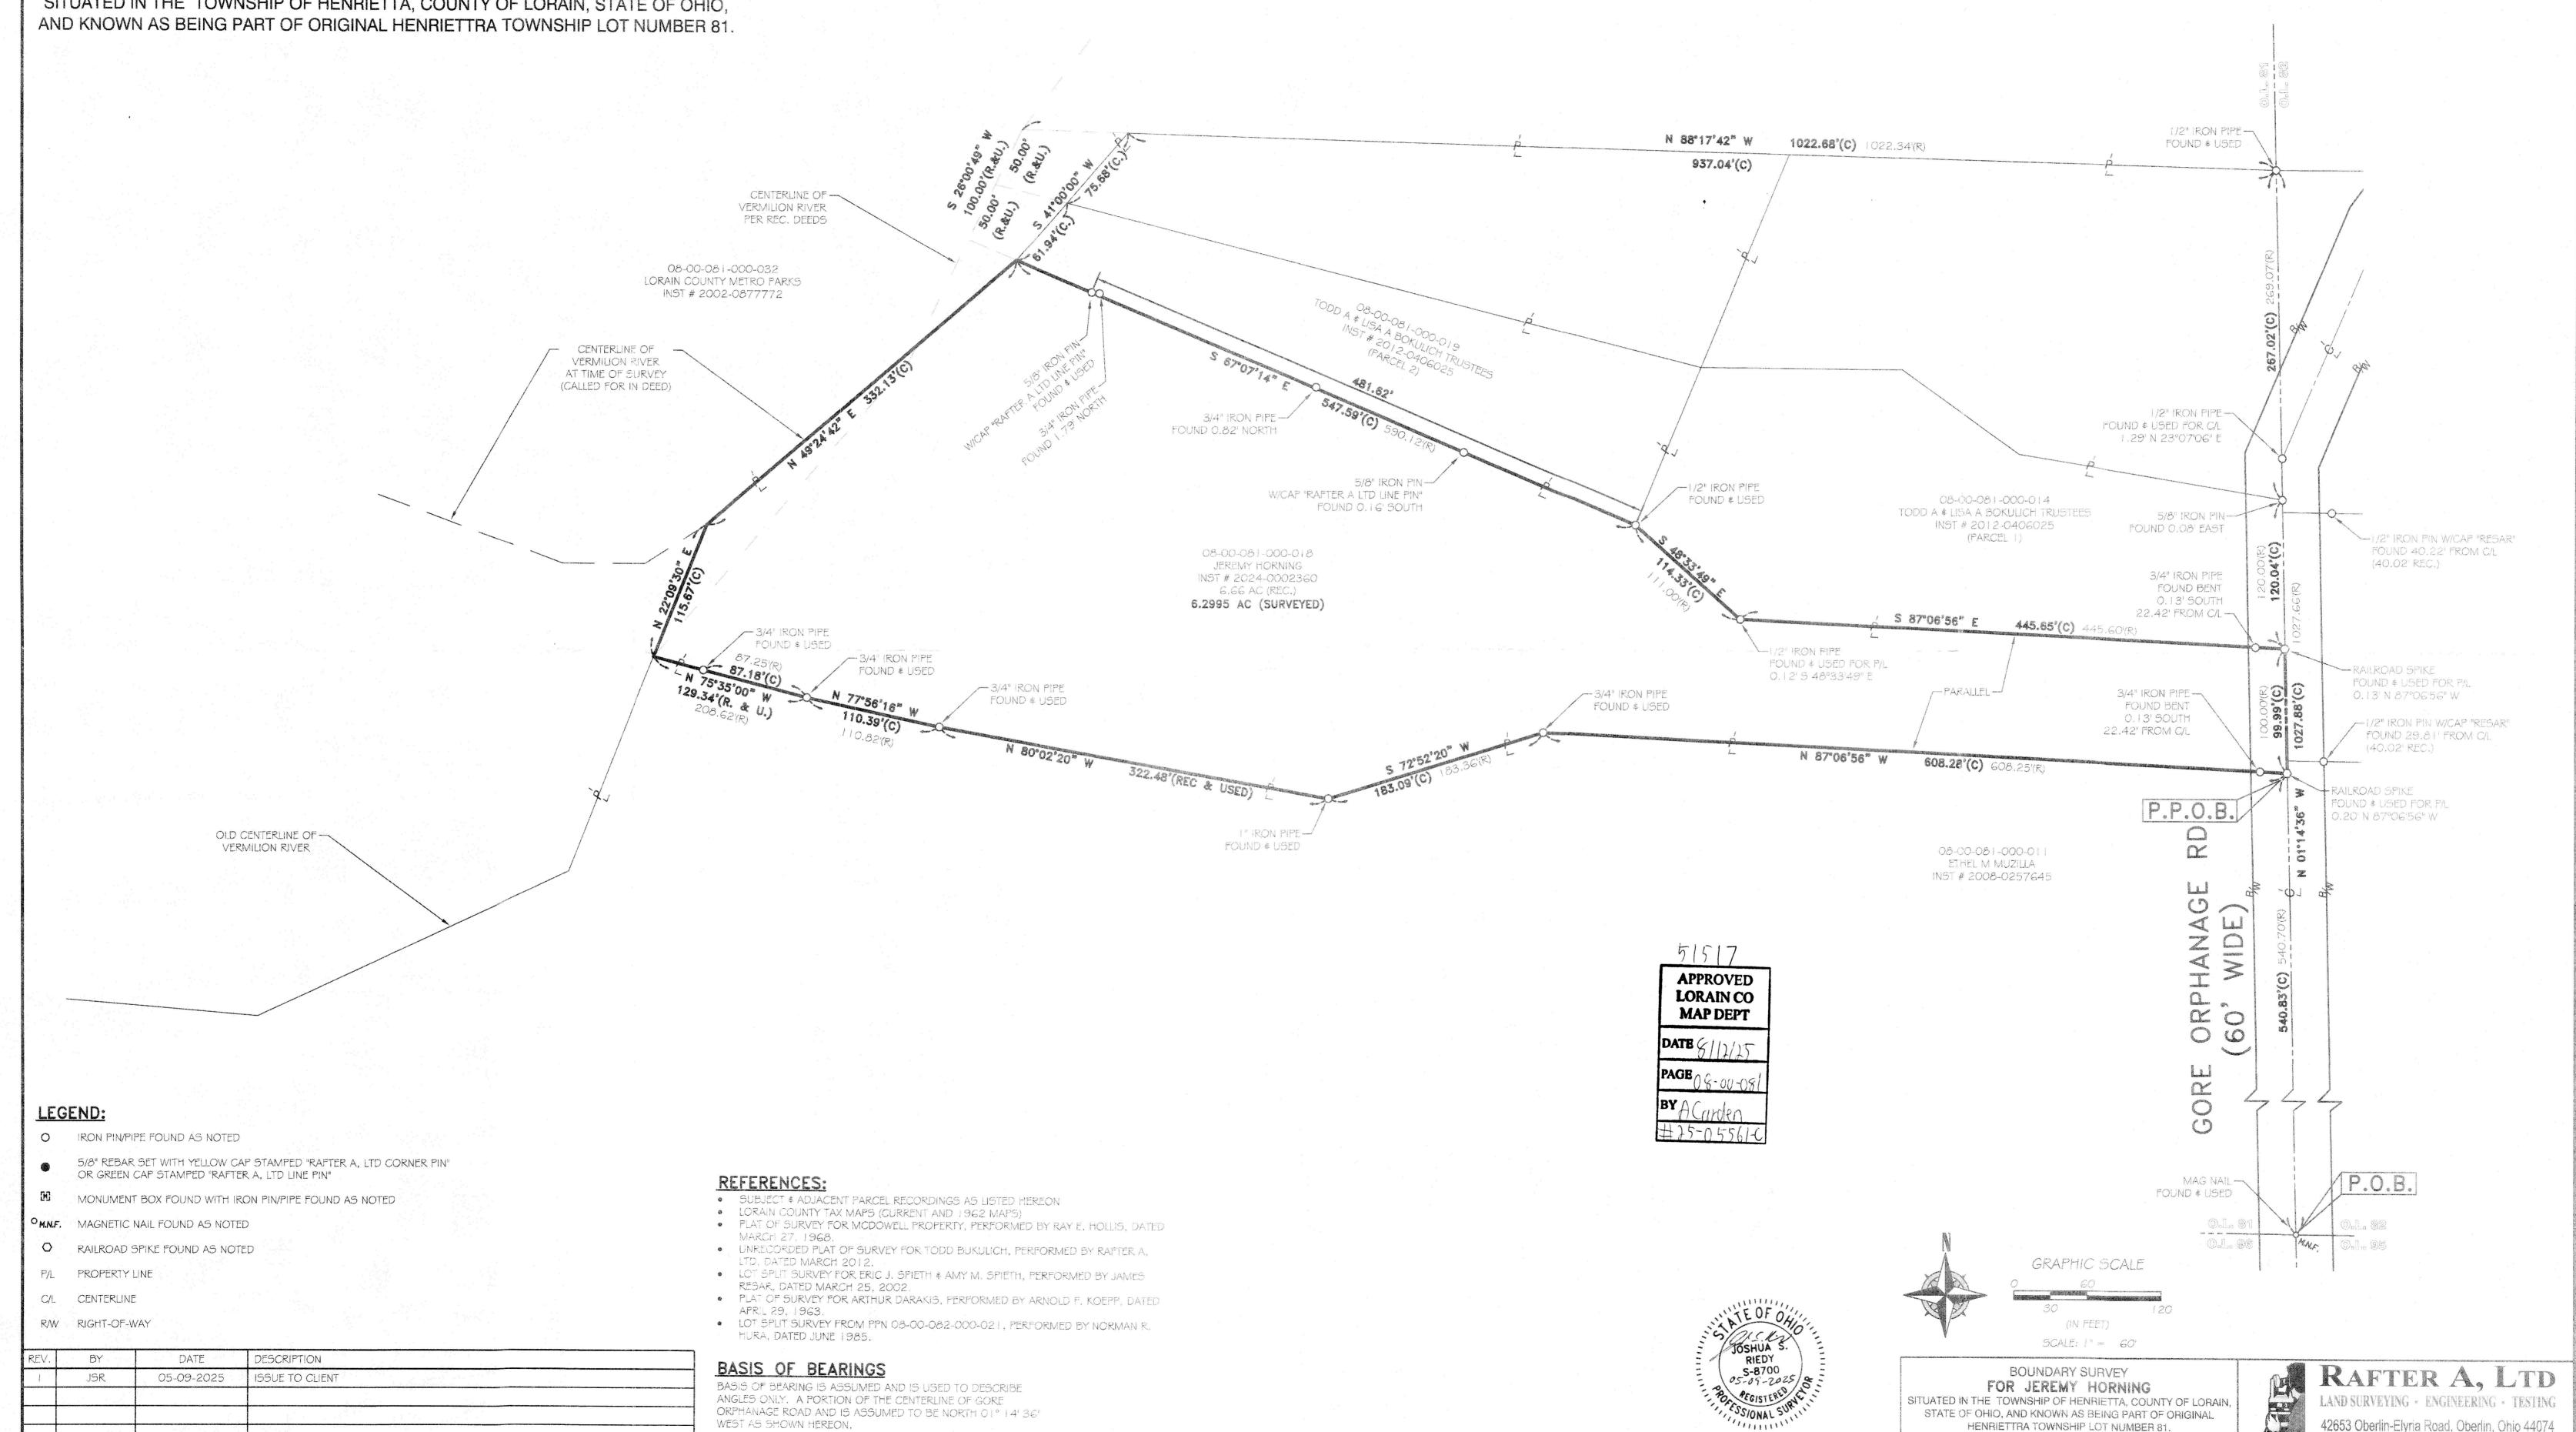

THIS SURVEY IS BASED UPON A FIELD SURVEY PERFORMED BY

RAFTER A., LTD IN APRIL AND MAY OF 2025.

440-707-4014 · www.raftera.com · info@raftera.com

CHECKED BY: JAD

SHEET 1 of 1

DRAWN BY: JSR

JOB No: 3745-25

JEREMY HORNING

9916 GORE ORPHANAGE

AMHERST, OHIO 44001