



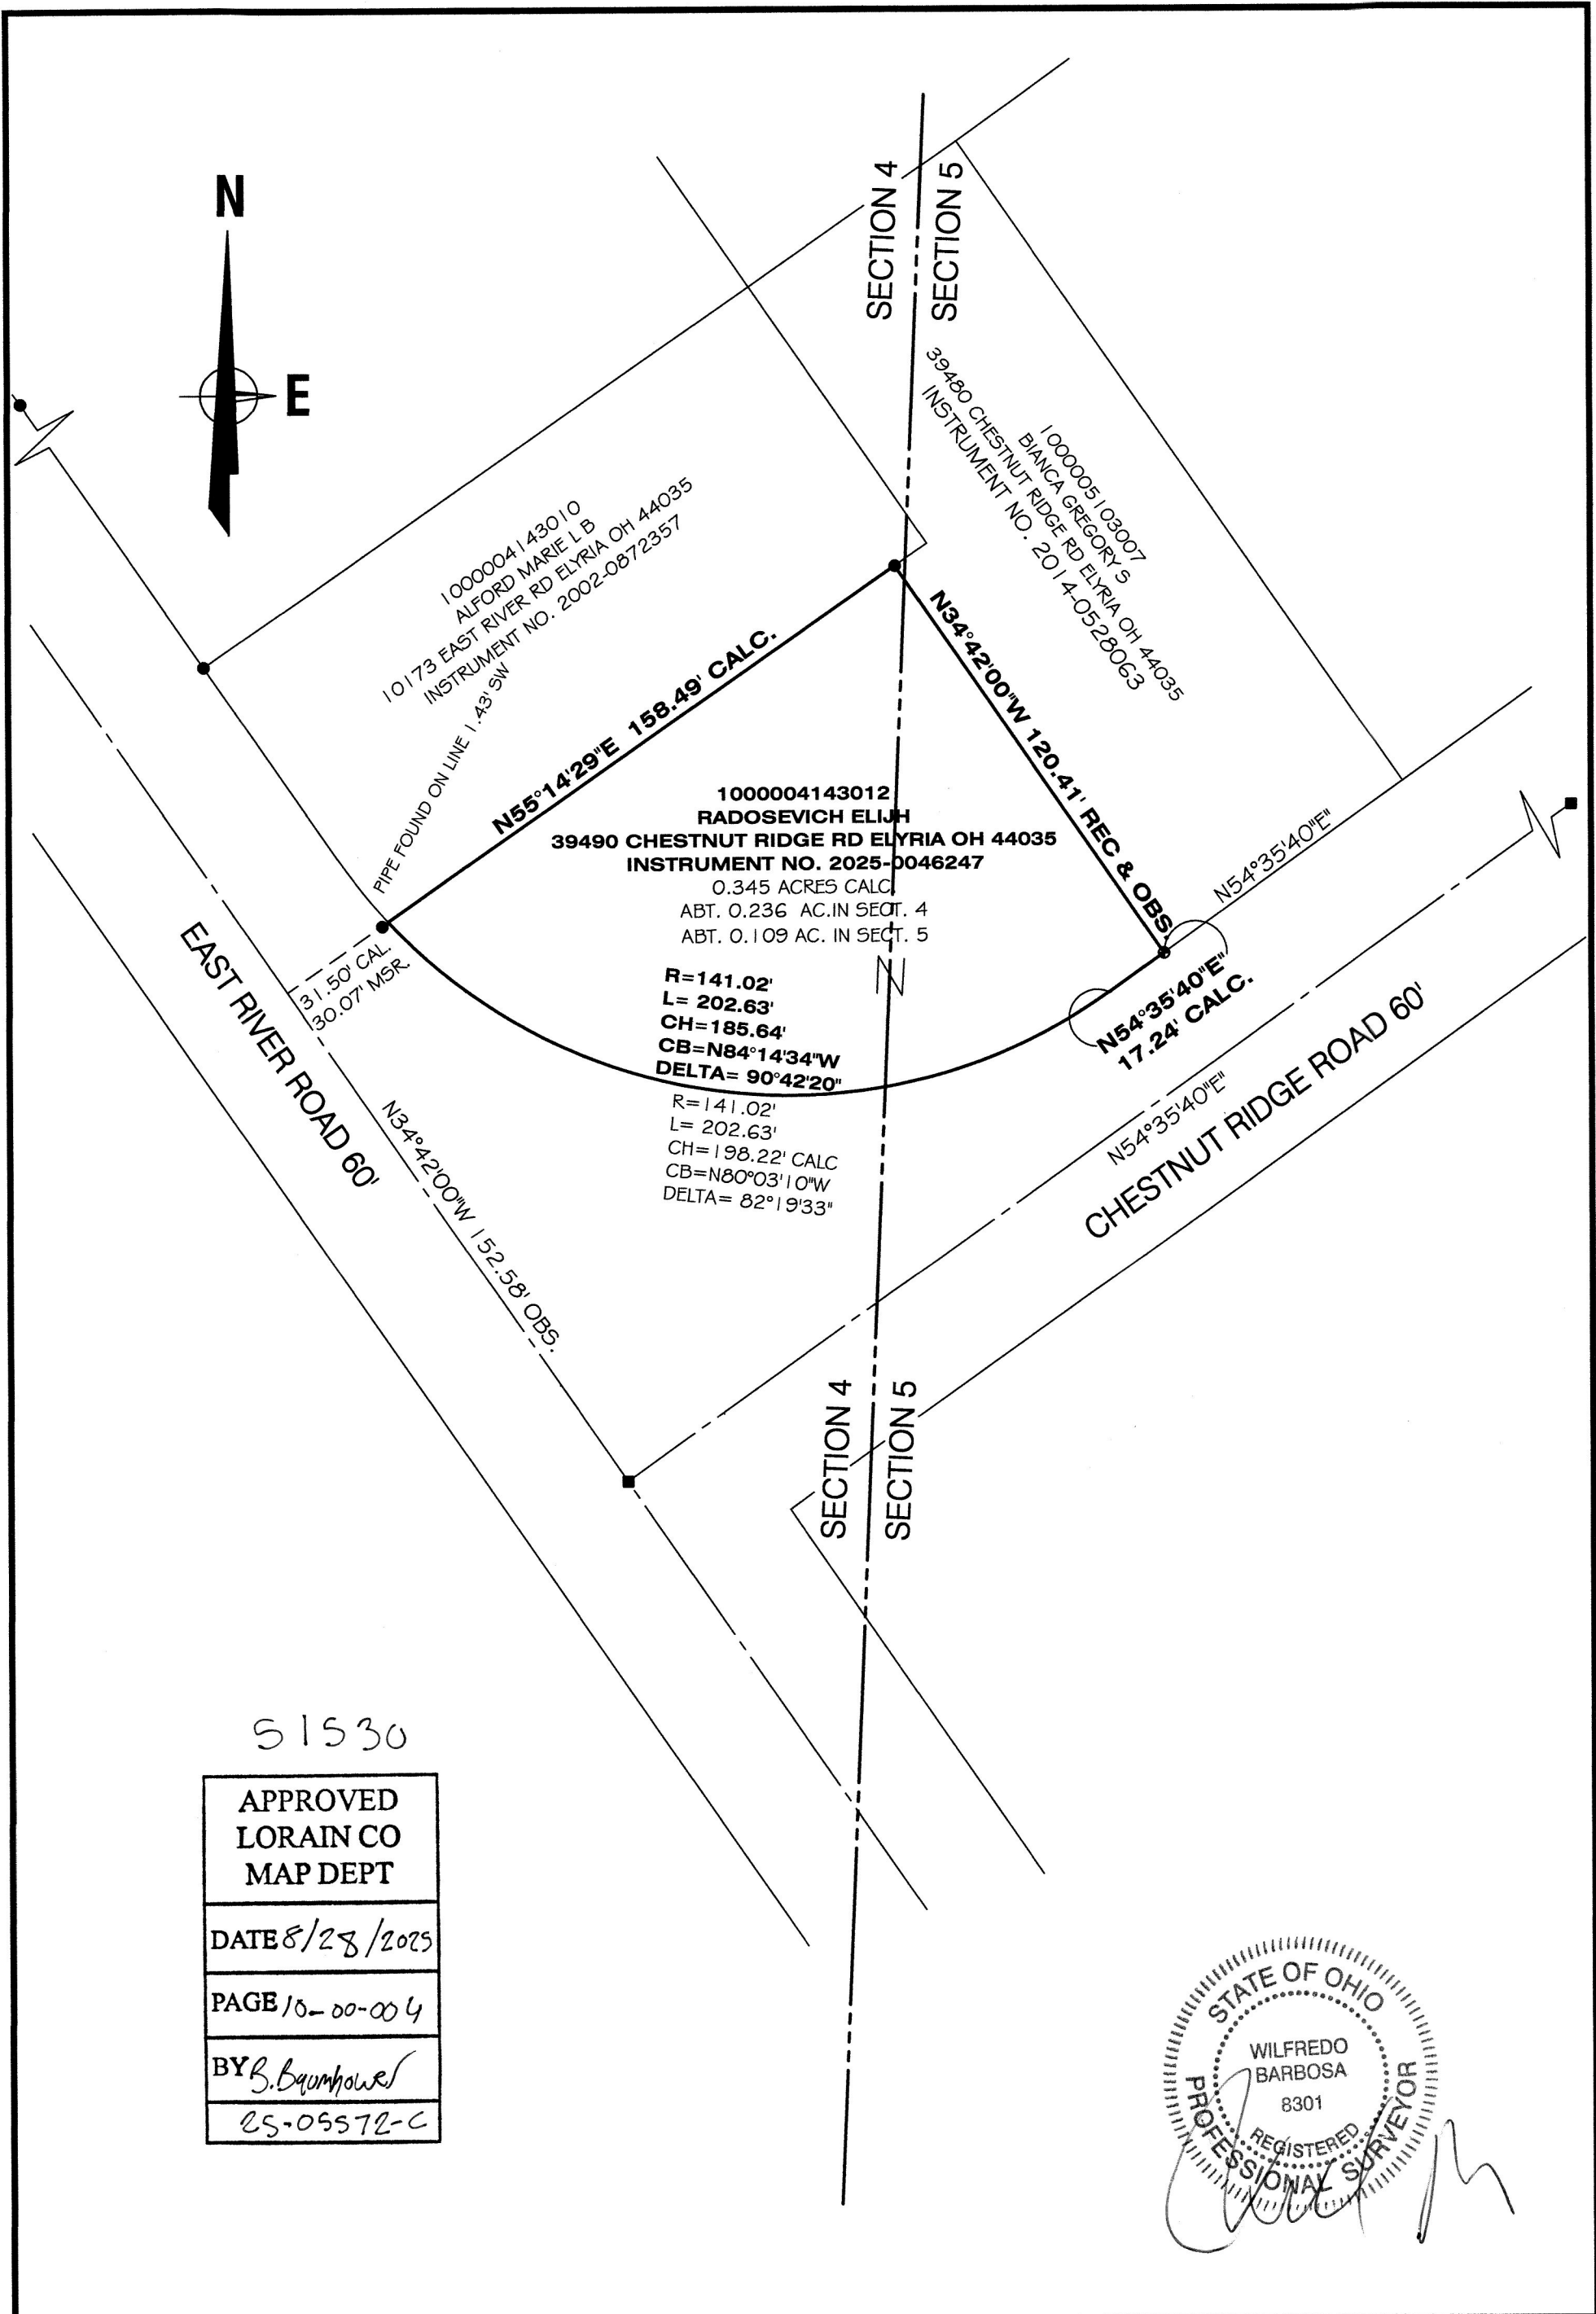

PREPARED FOR:
Elijah Radosevich
39490 Chestnut Ridge Road
Elyria, Ohio 44035

BARBOSA AND ASSOCIATES LLC
440 327-4776

GRAPHIC SCALE

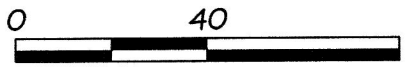

SCALE: 1" = 40'

SURVEY
10-00-004-143-012
PART OF
ORIGINAL CARLISLE TOWNSHIP SECTION 4
TOWNSHIP OF CARLISLE COUNTY OF LORAIN
STATE OF OHIO

AUG. 2025 JOB No: 2025-8-1

LEGEND:
⊕ = MAG NAIL ⊗ = DRILL HOLE SET
⊙ = 1/2" REBAR SET WITH I.D. CAP
○ = PIPE FOUND ● = PIPE USED
▲ = IRON PIN/ REBAR FOUND
△ = IRON PIN/ REBAR FOUND AND USED
■ = MONUMENT BOX
R, REC = RECORD U= USED
C, CALC = CALCULATED T.M. = TAX MAP
OBS = OBSERVED CL = CENTERLINE