
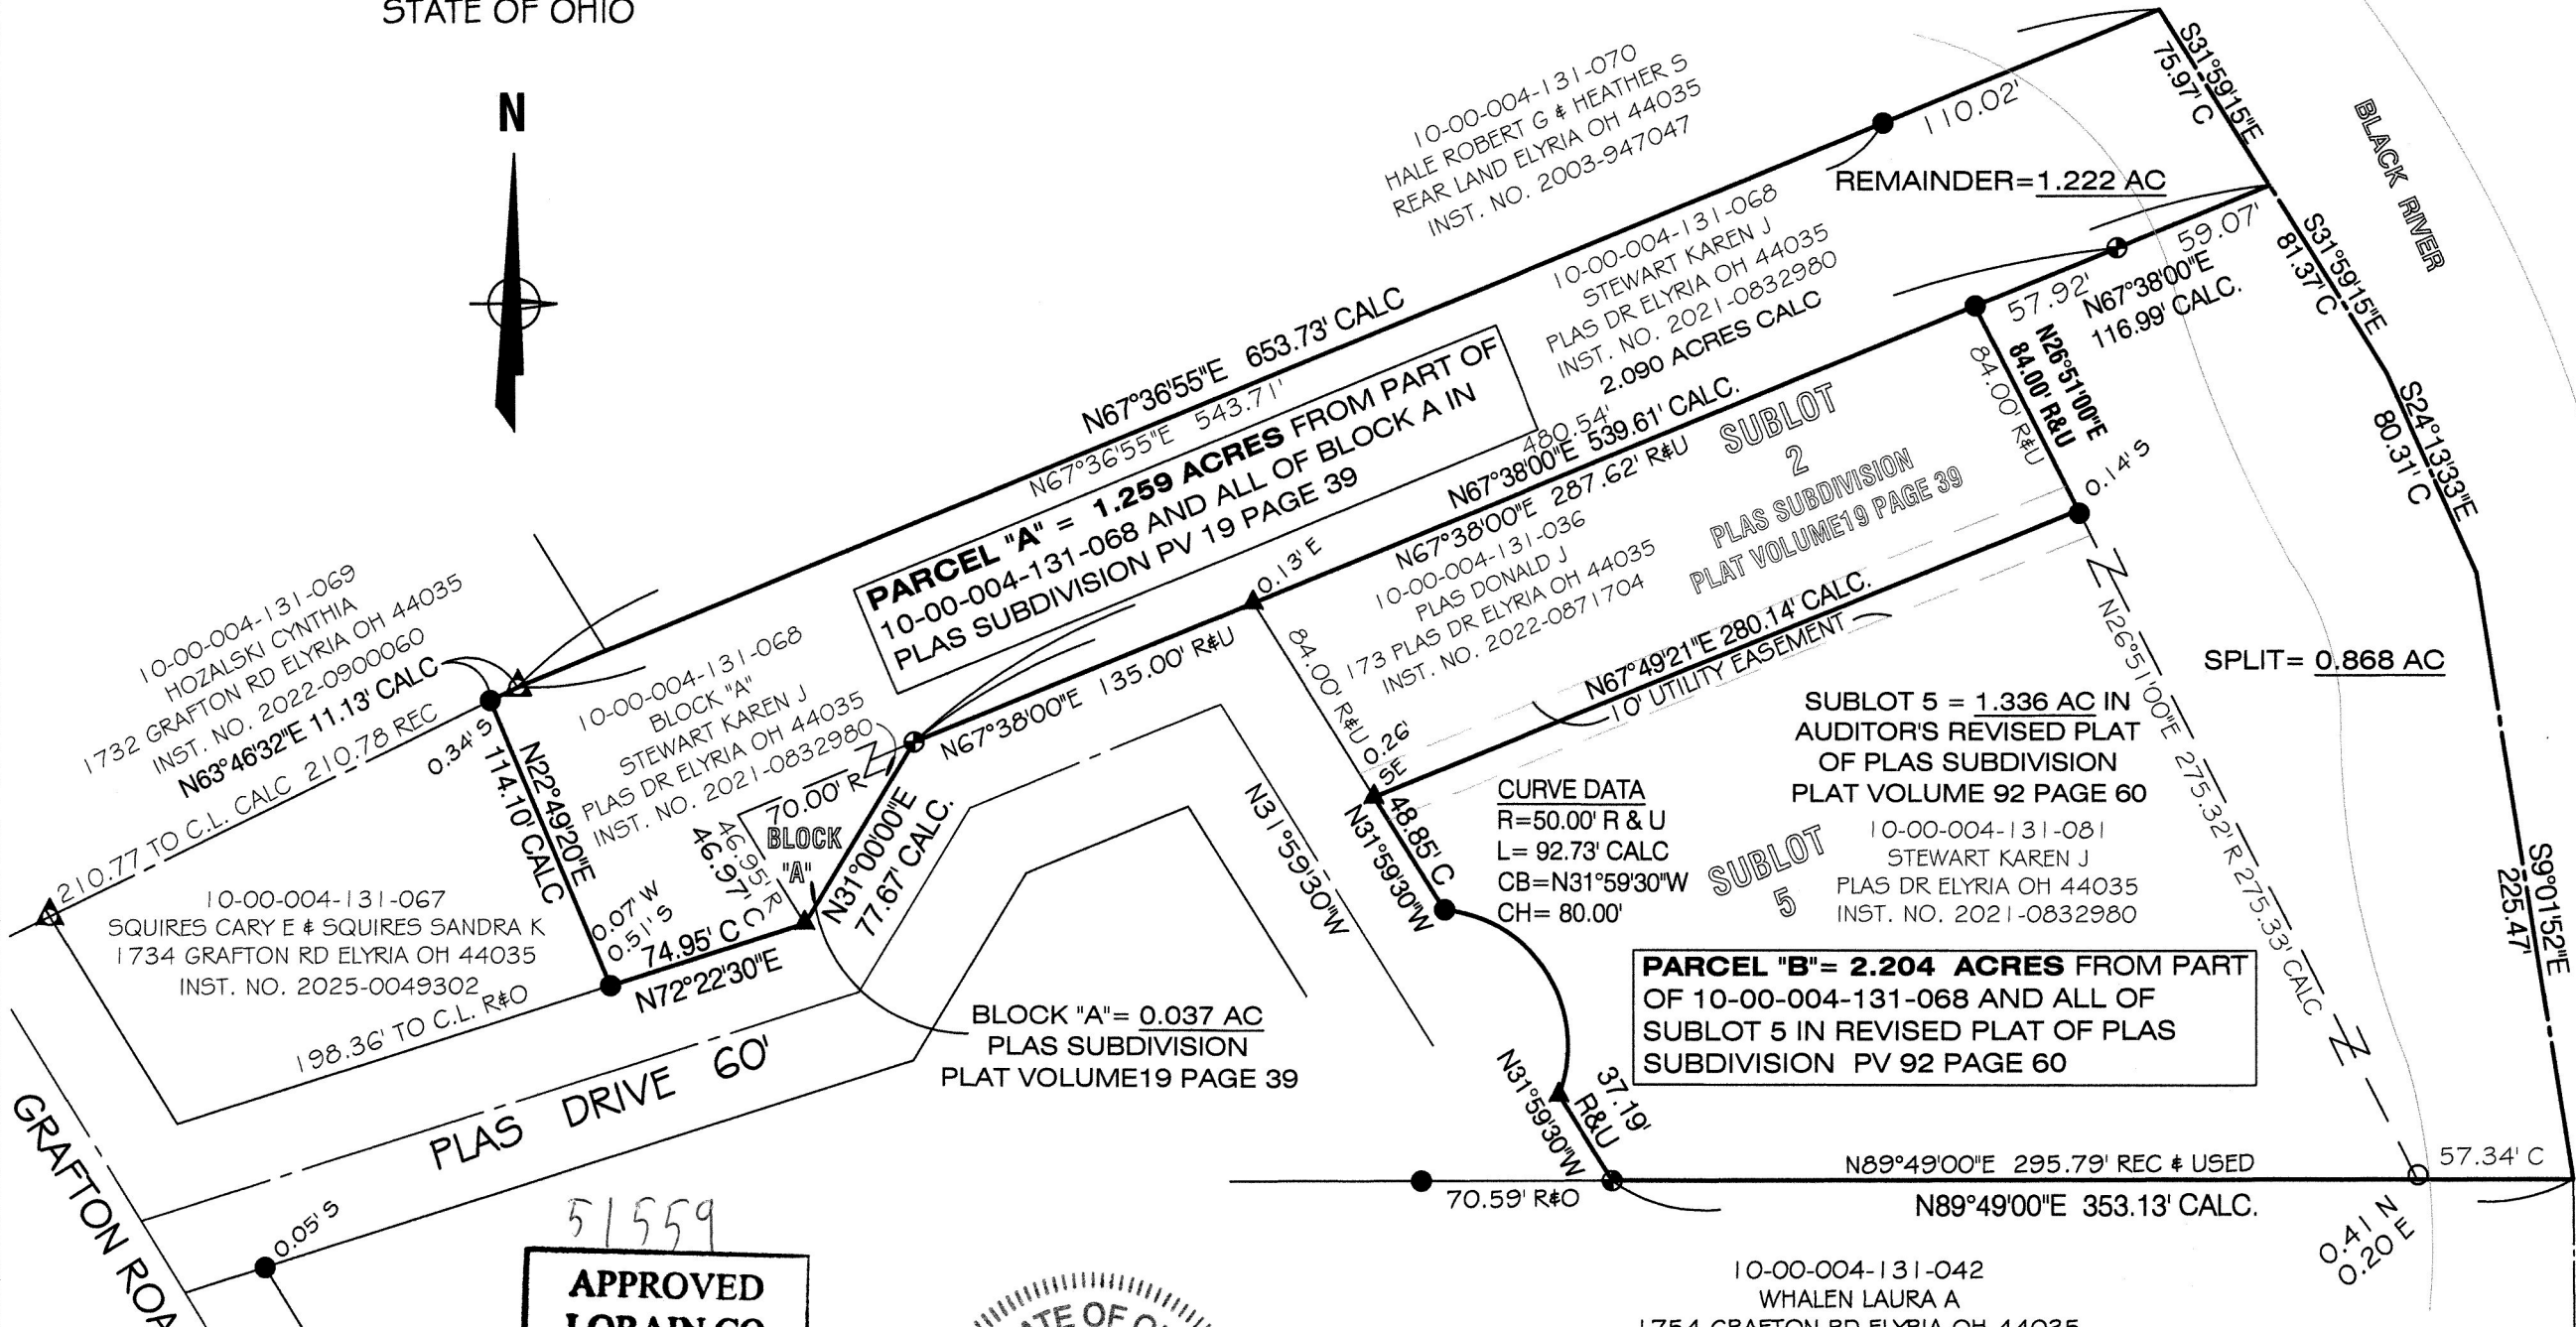


SURVEY WITH SPLIT CONSOLIDATION
OF PART OF SECTION 4 CARLISLE TOWNSHIP
TOWNSHIP OF CARLISLE COUNTY OF LORAIN
STATE OF OHIO

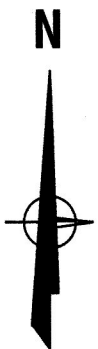


GRAFTON ROAD 60'

PLAS DRIVE 60'

BLACK RIVER

51559

APPROVED
LORAIN CO
MAP DEPT
DATE 10/3/25
PAGE 10-00-004
BY ACarden
#25-05070

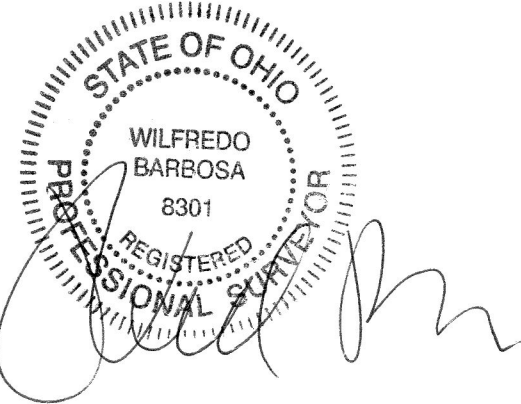

10-00-004-131-042
WHALEN LAURA A
1754 GRAFTON RD ELYRIA OH 44035
INST. NO. 2019-0725189

LEGEND:

- ⊗ = MAGSPK SET
- ⊙ = 5/8" REBAR SET WITH I.D. CAP
- = PIPE FOUND
- = PIPE FOUND AND USED
- ▲ = IRON PIN/ REBAR FOUND
- ▲ = IRON PIN/ REBAR FOUND AND USED
- = WOOD STAKE
- ⊠ = MONUMENT BOX

R, REC = RECORD U= USED C, CALC = CALCULATED
OBS = OBSERVED
CL = CENTERLINE
R.O.W. = RIGHT-OF-WAY. ROAD RIGHT-OF-WAY

PREPARED AT THE REQUEST OF: Karen Stewart 169 Plas Drive Elyria, Ohio 44035	GRAPHIC SCALE 0 70 140 35 (IN FEET) SCALE: 1" = 70'	
	SHEET 1 of 1	
SITE: PARCEL 10-00-004-131-068, -081 and -034	CHECKED BY: WB	
	4/20/2025	
JOB No: 2024-10-7		
BARBOSA AND ASSOCIATES LLC 5604 CASE ROAD NORTH RIDGEVILLE, OH 44039 440 327-4776		