


BOUNDARY SURVEY

FOR

MICHAEL & PAMELA DeANNA

SITUATED IN THE CITY OF ELYRIA, COUNTY OF LORAIN,
STATE OF OHIO,
KNOWN AS BEING PART OF ORIGINAL ELYRIA TOWNSHIP
LOT NUMBER 26, WEST OF THE BLACK RIVER

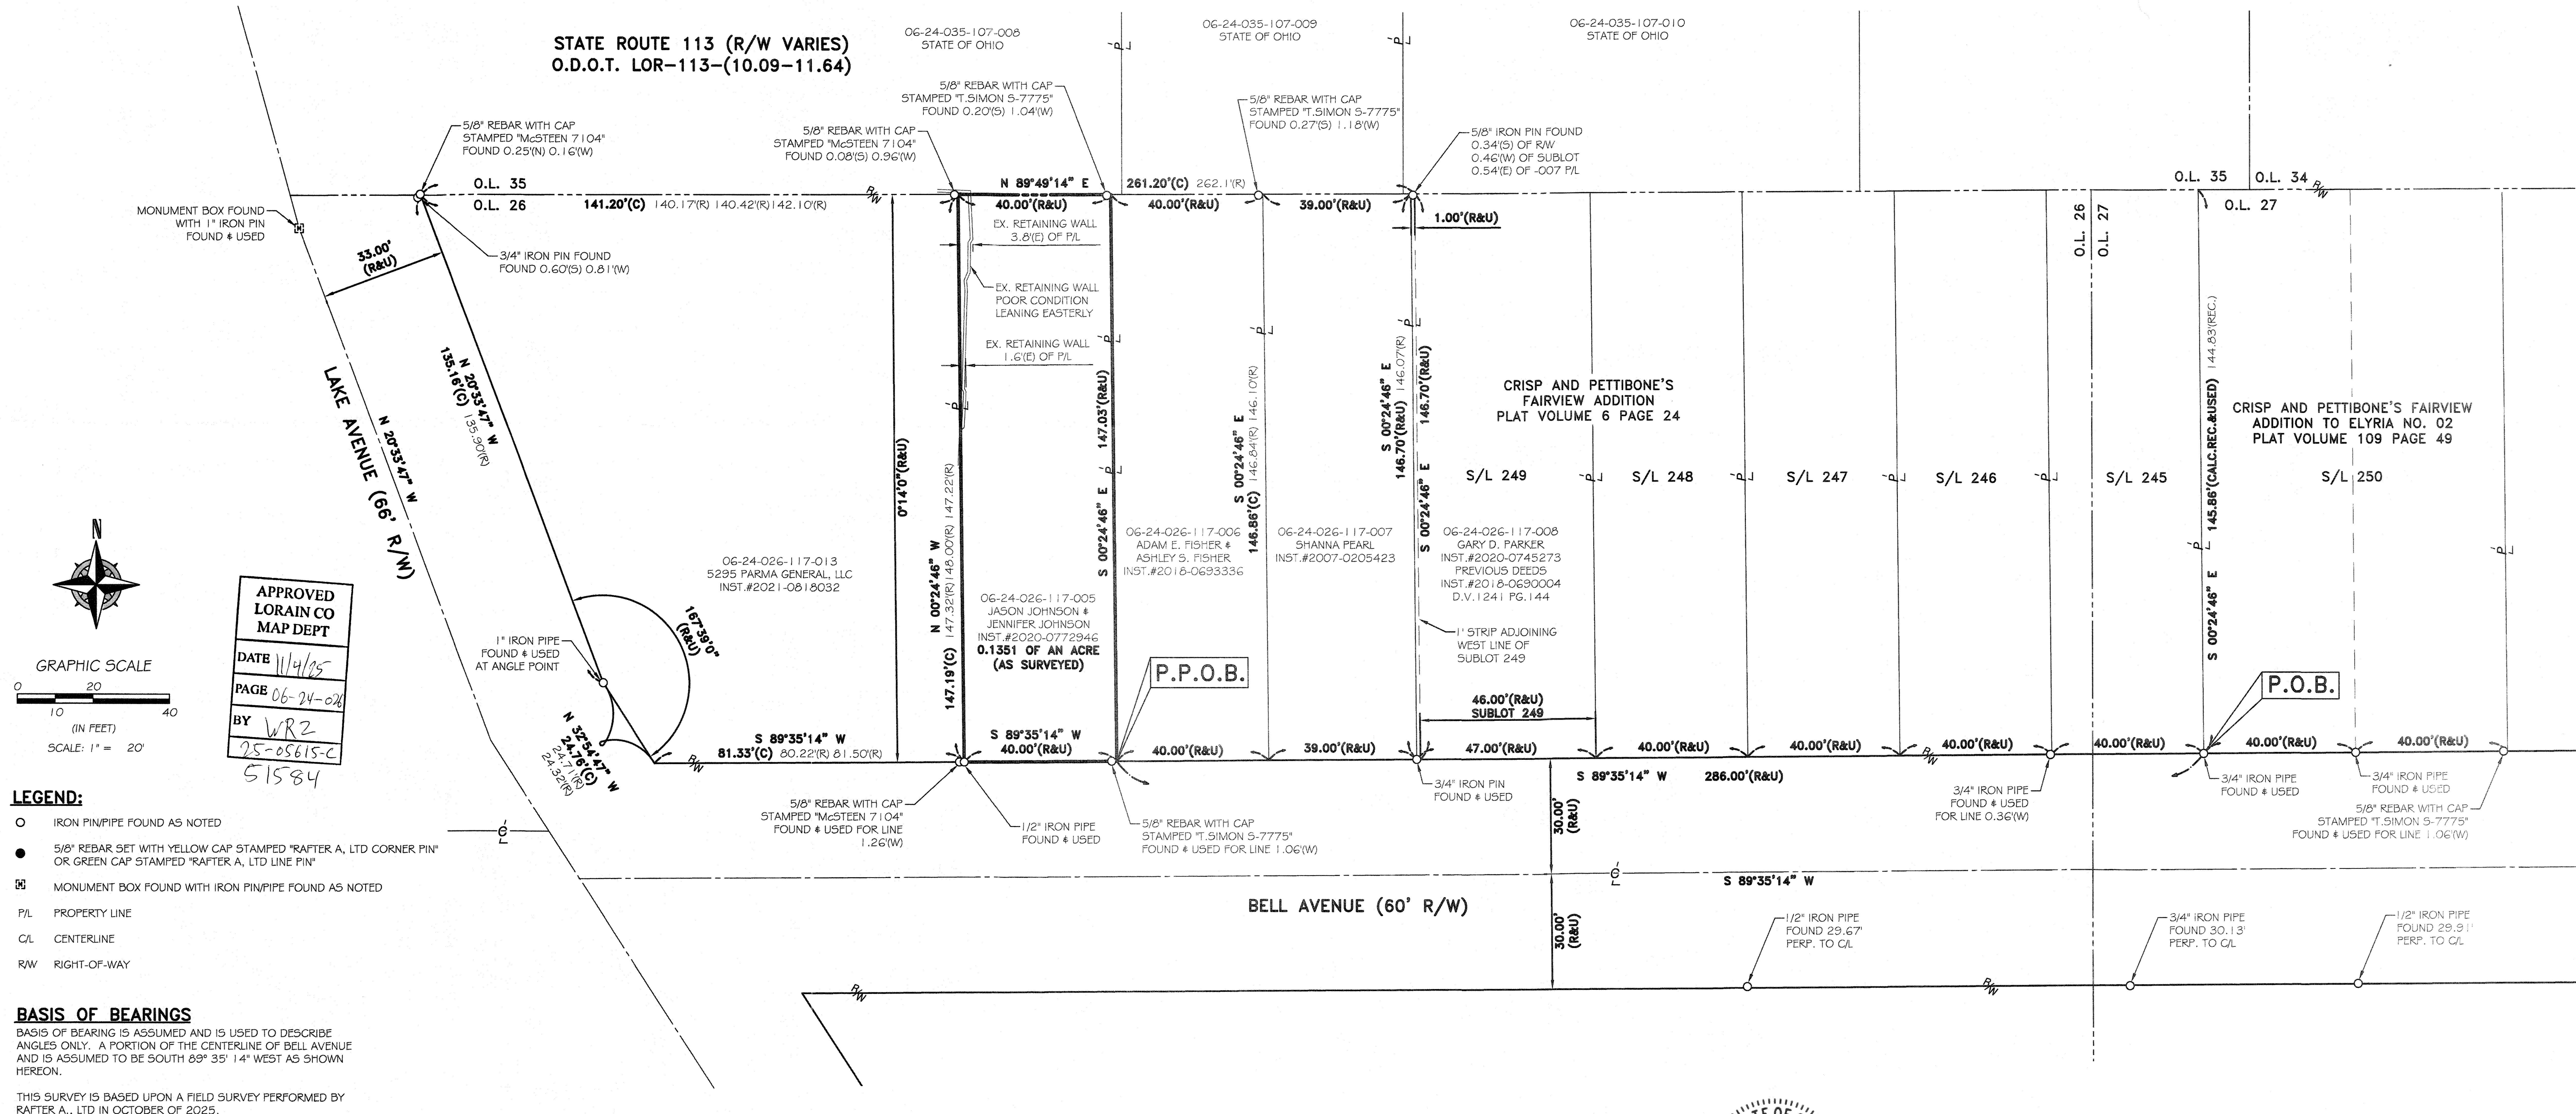

APPROVED LORAIN CO MAP DEPT

DATE 11/4/25
PAGE 06-24-026
BY WR2
25-05615-C
51584

REFERENCES:

- SUBJECT & ADJACENT PARCEL RECORDINGS AS LISTED HEREON
- LORAIN COUNTY TAX MAPS (CURRENT AND 1962 MAPS)
- MAP OF SURVEY FOR 106 BELL AVENUE, McSTEEN & ASSOCIATES, INC.
- ROBERT A. DORNER, P.S. 6943, DATED MARCH 14, 2008
- PLAT OF BOUNDARY SURVEY FOR JOE MALICK, JR. AND JOANN M. THURSTON, THOMAS SIMON & ASSOCIATES, INC. THOMAS A. SIMON, P.S. 7775, DATED MARCH 2018



REV.	BY	DATE	DESCRIPTION
1	JAD	10-28-2025	ISSUE TO CLIENT

P.P.N. 06-24-026-117-005 BOUNDARY SURVEY 110 BELL AVENUE, ELYRIA, OHIO 44035 MICHAEL & PAMELA DeANNA 125 HILLIARD ROAD, ELYRIA, OHIO 44035	RAFTER A, LTD LAND SURVEYING • ENGINEERING • TESTING 42653 Oberlin-Elyria Road, Oberlin, Ohio 44074 440-707-4014 • www.raftera.com • info@raftera.com DRAWN BY: JAD JOB No: 3940-25 CHECKED BY: JSR SHEET 1 of 1
---	--