



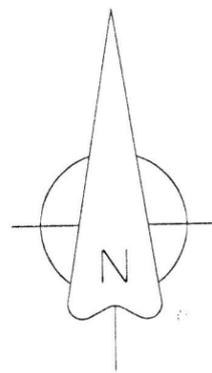

DIMENSIONS SHOWN ON THIS PLAT ARE EXPRESSED IN FEET AND DECIMAL PARTS THEREOF. ALL BEARINGS ARE TO AN ASSUMED MERIDIAN AND ARE USED TO DESCRIBE ANGLES ONLY. PERMANENT MONUMENTS WERE FOUND OR SET AS INDICATED HEREON, ALL OF WHICH I CERTIFY TO BE CORRECT.


TAS
 THOMAS A. SIMON, REGISTERED
 PROFESSIONAL SURVEYOR NO. S-7775

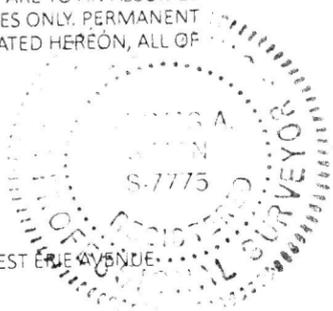

BASIS OF BEARINGS IS THE CENTERLINE OF WEST ERIE AVENUE (NORTH 59°16'00" EAST).

51652

APPROVED
LORAIN CO
MAP DEPT
DATE 2/10/26
PAGE 02-02-022
BY A. Curden
#26-05663-C

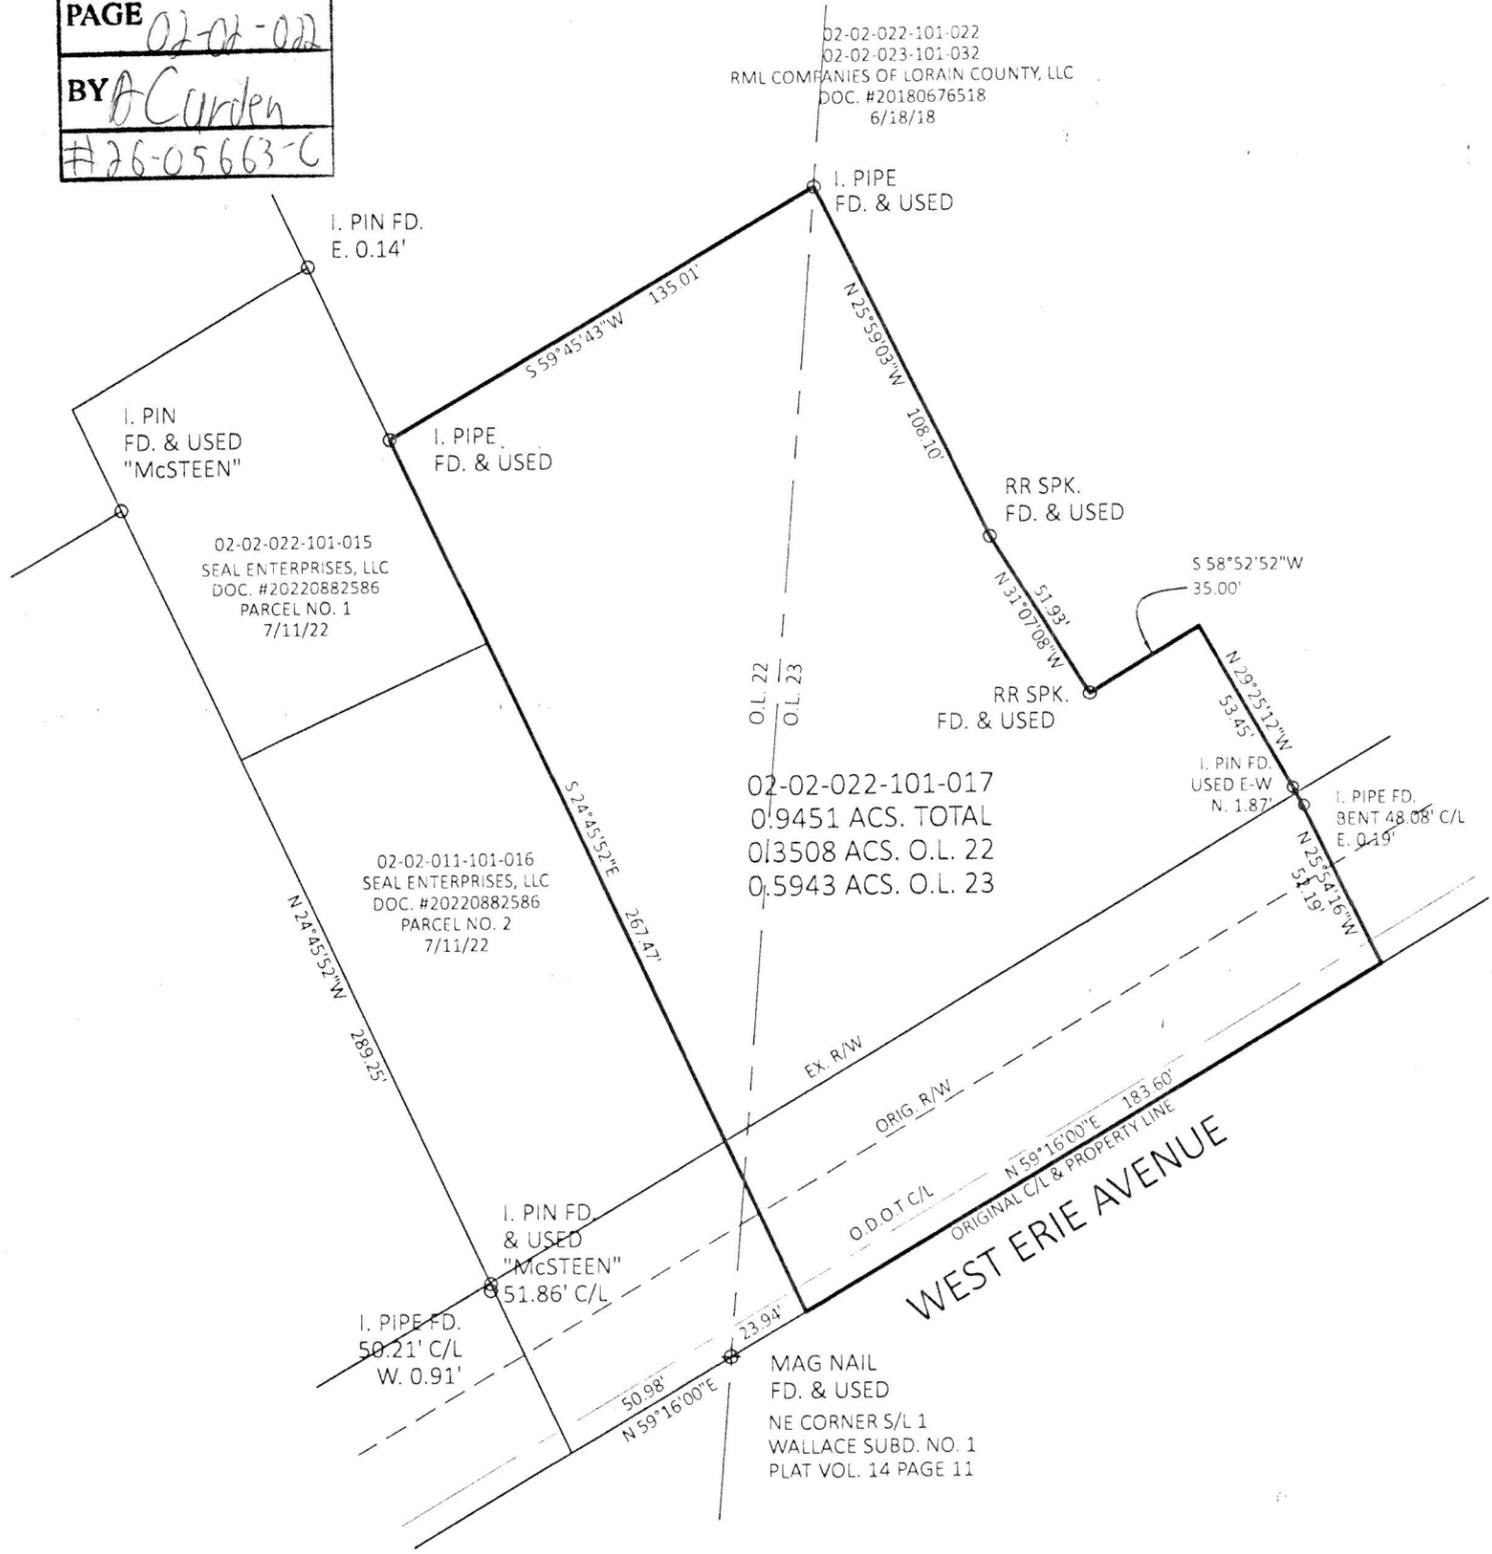

THOMAS SIMON & ASSOCIATES, INC.
 PROFESSIONAL LAND SURVEYORS
 150 SOUTH OLIVE STREET
 ELYRIA, OHIO 44035
 (440) 327-2925
 TASIMON@WINDSTREAM.NET

PLAT OF BOUNDARY SURVEY
 FOR
 STEPHANIE DANAILOVSKI
 BEING KNOWN AS PARTS OF
 ORIGINAL BLACK RIVER TOWNSHIP
 LOT NOS 22 AND 23
 TRACT 2

CITY OF LORAIN COUNTY OF LORAIN
 STATE OF OHIO
 OCTOBER, 2025 SCALE: 1" = 50'